

SURVEY & REMONUMENTATION

APR 27 1995

COMMISSION

LAND CORNER RECORDATION CERTIFICATE

Filing Requirement of Act 74, Mich. P.A. 1970

STATE OF MICHIGAN
COUNTY OF KENT
RECEIVED FOR RECORD

DEC 28 PM 2:15

For corners in
Kent
(County)

Located In:

Corner Code #

- | | | | | | |
|------------------------------------|---|----|---|-----|-----|
| 1. Public Land Survey | T | 5N | R | 12W | L-8 |
| | T | | R | | |
| | T | | R | | |
| | T | | R | | |
| 2. Property Controlling in Section | S | | T | R | |
| | S | | T | R | |
| 3. Miscellaneous Property in Sec. | S | | T | R | |
| | S | | T | R | |

Twigg
REG. OF DEEDS

7925

Register of Deeds Stamp & File Number

4. Lot No. _____, Recorded Plat _____
5. Private Claims _____

I, Douglas W. Bonnema, in a field survey on Nov. 16, 1994, do hereby certify that under requirements of P.A. 74, Michigan P.A. of 1970, the corner points mentioned in lines 1 and 2 above were in conformance with regulations and rules therefore as required in the current manual of survey instructions of the United States Department of the Interior, Bureau of Land Management or by a decree of a Court of Law and/or that the corner points mentioned in lines 3, 4 and 5 above were in conformance with the rules of the Michigan Board of Land Surveyors or by a Decree of a Court of Law; established, re-established, monumented, re-monumented, recovered, found as expressed below:

NOTE: Not more than 4 corners, all in the same town and range, may be recorded on this certificate.

A. Description of original monument and accessories and/or subsequent restoration:

Since this is not a government corner there is no G.L.O. information.

Williams & Works 1930's Found and used gas pipe. They have since used it for several surveys, mostly along the perimeter of the Section. A L.C.R.C. was never recorded. This iron is 11' South and 1' East of intersection of 1/4 lines.

Exxel Engineering Dec. 1988 Set a capped iron at the intersection of the 1/4 lines in an extensive survey which included land in all four quarter sections.

B. Description of corner evidence found and/or method applied in restoring or reestablishing corner:

Found and accepted the Exxel Engineering iron after discussion with County Peer Group.

Nail in E sde 24" Maple	South 20.26'
Nail in SE sde 36" Maple	SW 35.12'
Nail in NE sde 12" Apple	NW 24.73'
Nail in NW sde 10" Apple	NE 32.74'

P.A. 345 1990 KENT COUNTY

PEER APPROVED 10/12/94

CHAIRMAN *Harry Kuper*


These all check with 1988 Exxel Engineering witnesses.

The selected location is accepted by me and is generally accepted by professional surveyors as the best available evidence of the position of the corner.

C. Description of monument for corner and accessories established to perpetuate locating the position of the corner:

Replaced Exxel capped iron with 4" x 30" Kent County Cast Iron Mon.

Nail & KC tag in NE sde of 15" Apple	N24°W 24.73'
Nail & KC tag in NW sde of 12" Apple	N60°E 32.74'
Nail & KC tag in E'ly sde of 26" Maple	S05°W 20.23'
Nail & KC tag in SE sde 40" Maple	S45°W 35.09'
Nail & KC tag in W'ly sde of 28" Maple	S11°W 44.72'
Bottom of 4" dia. steel fence cor post	S02°E 11.5'

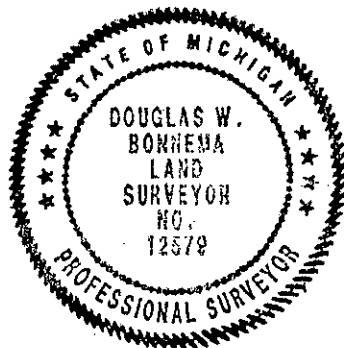

Signed by *Douglas W. Bonnema*

Date 12/14/94

Surveyor's Michigan License No. 12579