

SEP 18 1995

COMMISSION

LAND CORNER RECORDATION CERTIFICATE Filing Requirement of Act 74, Mich. P.A. 1970 KENT COUNTY REMONUMENTATION

For corners in

Kent
(County)

Located in:

Corner Code #

1. Public Land Survey

T 5N R 12W

L-9

2. Property Controlling
in SectionS T R 3. Miscellaneous
Property in Sec.S T R S T R 4. Lot No. , Recorded Plat 5. Private Claims

I, Randy Kolehose, in a field survey on April 3 19 95, do hereby certify that under requirements of P.A. 74 Michigan P.A. of 1970, the corner points mentioned in lines 1 and 2 above were in conformance with regulations and rules therefore as required in the current manual of survey instructions of the United States Department of the interior, Bureau of Land Management or by a decree of a Court of Law and/or that the corner points mentioned in lines 3, 4 and 5 above were in conformance with the rules of the Michigan Board of Land Surveyors or by a Decree of a Court of Law; established, re-established, monumented, re-monumented, recovered, found as expressed below:

NOTE: Not more than 4 corners, all in the same town and range, may be recorded on this certificate.

A. Description of original monument and accessories and/or subsequent restoration:

L-9	1831	G.L.O. Notes	Mullett	Set Post
	1934	Wit. Map	K.C. Surveyor	Stone
	1976	L.C.R.C. #1008	Medema, Van Kooten & Assoc.	Found "T" Iron
	1981	L.C.R.C. #2864	Jonker Land Surveys	Found 3/4" x 20" Iron/Set K.C. Monument
	1991	L.C.R.C. #6359	Chris Marschall	K.C. Monument

This corner was originally approved by the Kent County Remonumentation Peer Group and monumented by Jonker Land Surveys on 5/10/82 and was recorded per L.C.R.C. #2864.

B. Description of corner evidence found and/or method applied in restoring or reestablishing corner:

L-9 Found standard Kent County Monument 5' South of South edge of 92nd Street running E-W per L.C.R.C.'s #2864 and #6359 as set by Jonker Land Surveys in place of a 3/4" x 20" iron they found.

L.C.R.C. #2864

Remon. tag on NE side 12" Oak S55°E 50.10'
Remon. tag on S side p. pole N 70°E 114.75'
Sq. spike on NE side 20" Maple N40°W 77.70'
Sq. spike on E side 26" W Cherry N10°W 59.82'

L.C.R.C. #6359

Nail & Tag E side 10" Maple 6' High S 6 E 24.67'
Nail & Tag NE side 16" Oak S 64 E 49.99'
Nail & Tag NE side 24" Maple N 40 W 77.83'
Nail & Tag S side P.P. N 70 E 114.73'
Sq. spike E. side 26" Cherry N 10 W 59.80'

The selected location is accepted by me and is generally accepted by professional surveyors as the best available evidence of the position of the original corner.

C. Description of monument for corner and accessories established to perpetuate locating the position of the corner:

L-9 Standard Kent County Monument

Nail & K.C. remon. tag on E side 10" Maple 6' high S 06° E 24.67'
Nail & K.C. remon. tag on NE side 16" Oak S 64° E 49.99'
Nail & K.C. remon. tag on NE side 24" Maple N 40° W 77.83'
Nail & K.C. remon. tag on S side P. pole N 70° E 114.73'
Sq. spike E. side 26" Cherry N 10° W 59.80'

Signed by Randy J. Kolehose

EARTH TECH

Date

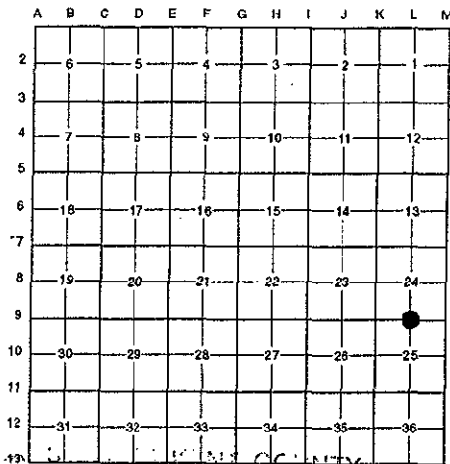
8/21/95Surveyor's Michigan License No. 25854

REG. OF DEEDS

8661

Register of Deeds Stamp & File Number

95 AUG 28 AM 10:55

STATE OF MICHIGAN
COUNTY OF KENT
RECEIVED FOR RECORD

PEER APPROVED 6/27/95
CHAIRMAN Randy Kolehose

