

\$7.00  
\$2.00

JAN 23 1996

Seq 2

COMMISSION LAND CORNER RECORDATION CERTIFICATE  
Filing Requirement of Act 74, Mich. P.A. 1970  
KENT COUNTY REMONUMENTATION

For corners in

Kent (County)	Located in:	Corner Code #
1. Public Land Survey	T <u>5N</u> R <u>12W</u>	<u>B-12</u>
	T _____ R _____	_____
	T _____ R _____	_____
	T _____ R _____	_____
2. Property Controlling in Section	S _____ T _____ R _____	<u>Seq. 2</u>
	S _____ T _____ R _____	_____
3. Miscellaneous Property in Sec.	S _____ T _____ R _____	_____
	S _____ T _____ R _____	_____

4. Lot No. \_\_\_\_\_, Recorded Plat \_\_\_\_\_

5. Private Claims \_\_\_\_\_

STATE OF MICHIGAN  
COUNTY OF KENT  
RECEIVED FOR RECORD

95 DEC 28 PM 2:18

REG. OF DEEDS  
8882

Register of Deeds Stamp & File Number

I, Randy Kolehouse, in a field survey on March 14 19 95, do hereby certify that under requirements of P.A. 74 Michigan P.A. of 1970, the corner points mentioned in lines 1 and 2 above were in conformance with regulations and rules therefore as required in the current manual of survey instructions of the United States Department of the interior, Bureau of Land Management or by a decree of a Court of Law and/or that the corner points mentioned in lines 3, 4 and 5 above were in conformance with the rules of the Michigan Board of Land Surveyors or by a Decree of a Court of Law; established, re-established, monumented, re-monumented, recovered, found as expressed below:

	A	B	C	D	E	F	G	H	I	J	K	L	M
2	6		5		4		3		2		1		
3													
4	7		8		9		10		11		12		
5													
6	18		17		16		15		14		13		
7													
8	19		20		21		22		23		24		
9													
10	30		29		28		27		26		25		
11													
12	31		32		33		34		35		36		
13													

NOTE: Not more than 4 corners, all in the same town and range, may be recorded on this certificate.

A. Description of original monument and accessories and/or subsequent restoration:

B-12 This corner was not originally set by the G.L.O.

1994 L.C.R.C. #7845 Jonker Land Surveys Set K.C. Monument at Int. of 1/4 Lines

P.A. 345 1990 KENT COUNTY  
PEER APPROVED 8/24/99  
CHAIRMAN Harry Huber

B. Description of corner evidence found and/or method applied in restoring or reestablishing corner:

B-12 Found K.C. Monument 2.5' South of the C/L of 104th Street per L.C.R.C. #7845. Monument is 0.1' North and 0.1' West of Intersection of 1/4 lines. Accepted Kent County Monument as Center Section.


L.C.R.C. #7845

Nail E. side P. pole Az. 350° 90.25'  
Spk. W. side 9" Elm Az. 175° 35.6'

C. Description of monument for corner and accessories established to perpetuate locating the position of the corner:

B-12 Standard Kent County Monument

- Nail & K.C. remon. tag in W side 8" Maple S 5° E 35.59'
- Nail & K.C. remon. tag in NE side 24" Maple S 45° E 84.84'
- Nail & K.C. remon. tag in E side P. pole N 13° W 90.28'
- Nail & K.C. remon. tag in N side 18" Maple S 88° W 144.73'

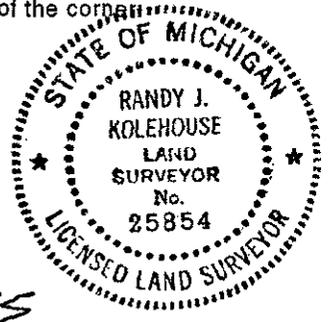

Signed by Randy J. Kolehouse  
EARTH TECH

Date 12/22/95

Surveyor's Michigan License No. 25854