

SURVEY & REMONUMENTATION

MAR 03 1998

KENT COUNTY REMONUMENTATION

SECTION

LAND CORNER RECORDATION CERTIFICATE
Filing Requirement of Act 74, Mich. P.A. 1970

STATE OF MICHIGAN
COUNTY OF KENT
RECEIVED FOR RECORD
97 NOV 13 PM 1:01
REG. OF DEEDS
Handwritten signature

For corners in
KENT COUNTY
(County)

Located In:	Corner Code #
T _____ R _____	_____
T _____ R _____	_____
T _____ R _____	_____
T _____ R _____	_____
S11 T6N R9W	Wit. Mon. on
S _____ T _____ R _____	N-S 1/4 line
S _____ T _____ R _____	_____
S _____ T _____ R _____	_____

other code # 7
10274

Register of Deeds Stamp & File Number

1. Public Land Survey

2. Property Controlling in Section

3. Miscellaneous Property in Sec.

4. Lot No. _____, Recorded Plat _____

5. Private Claims _____

I, Kirk Breitels, in a field survey on Sept. 18, 1997 do hereby state that under requirements of P.A. 74, Michigan P.A. of 1970, the corner points mentioned in lines 1 and 2 above were in conformance with regulations and rules therefore as required in the current manual of survey instructions of the United States Department of the Interior, Bureau of Land Management or by a decree of a Court of Law and /or that the corner points mentioned in lines 3, 4 and 5 above were in conformance with the rules of the Michigan Board of Land Surveyors or by a Decree of a Court of Law; established, re-established, monumented, recovered, found as expressed below:

NOTE: Not more than 2 corners, all in the same town and range, may be recorded on this certificate.

	A	B	C	D	E	F	G	H	I	J	K	L	M
1													
2	6		5		4		3		2		1		
3													
4	7		8		9		10		11		12		
5													
6	18		17		16		15		14		13		
7													
8	19		20		21		22		23		24		
9													
10	30		29		28		27		26		25		
11													
12	31		32		33		34		35		36		
13													

A. Description of original monument and accessories and/or subsequent restoration:

1953---Williams & Works---Surveys in the SW 1/4

See LCRC # 10272 for Central 1/4 corner (J-4) of Sec. 11

P.A. 345 1990 KENT COUNTY
PEER APPROVED 9/29/97
CHAIRMAN Harry Tubee

B. Description of corner evidence found and/or method applied in restoring or reestablishing corner:

Found 1" x 18" Iron Pipe at "NE corner N 1/2 of the SE 1/4 of the SW 1/4" of Sec. 11 per 1953 Williams & Works surveys. Found other property corners South of said Iron that falls on a line (±) created by said Iron and the South 1/4 corner of Sec. 11.


Meas. South to S 1/4 corner: 1335.70' - 1953 Williams & Works: 1336.2'

The Iron Pipe is accepted by me and is generally accepted by professional surveyors as the best available evidence of the property controlling corner.

C. Description of monument for corner and accessories established to perpetuate locating the position of the corner:

Set Harrison Monument with witness cap in place of the Iron Pipe

Nail & KC Remon. tag W. side Tri. 12"	Oak	N00°E	17.75'
Nail & KC Remon. tag E. side 26" Oak		S25°E	15.17'
Nail & KC Remon. tag SE side 8" Oak		S45°W	34.78'
Nail & KC Remon. tag N. side 18" Oak		N75°W	61.92'
Nail & KC Remon. tag NE side 8" Oak		N20°W	82.42'
Remains of N-S fence is East 5'±			

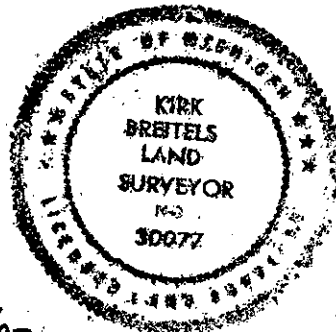

Signed by Kirk Breitels

Date 10/30/97

Surveyor's Michigan License No. 30077