

\$7.00
\$2.00

JAN 24 1996

KENT COUNTY REMONUMENTATION

COMMISSION

LAND CORNER RECORDATION CERTIFICATE

Filing Requirement of Act 74, Mich. P.A. 1970

For corners in
KENT COUNTY
(County)

Located In:

Corner Code #

1. Public Land Survey T R
- T R
- T R
- T R
2. Property Controlling S 9 T 6N R 11W
- in Section S T R
3. Miscellaneous S T R
- Property in Section S T R

Other Code
#2
Wit. Mon. on
E-W 1/4 line
Sec. 9

STATE OF MICHIGAN
COUNTY OF KENT
RECEIVED FOR RECORD
95 DEC 20 AM 8:38
REG. OF DEEDS
8804
Register of Deeds Stamp & File Number

4. Lot No. , Recorded Plat
5. Private Claims

I, Kirk Breitels, in a field survey on March 28, 19 95,
do hereby certify that under requirements of P.A. 74, Michigan P.A. of 1970, the corner points mentioned
in lines 1 and 2 above were in conformance with regulations and rules therefore as required in the current
manual of survey instructions of the United States Department of the Interior, Bureau of Land
Management or by a decree of a Court of Law and/or that the corner points mentioned in lines 3, 4 and
5 above were in conformance with the rules of the Michigan Board of Professional Surveyors or by a
Decree of a Court of Law; established, re-established, monumented, re-monumented, recovered, found
as expressed below:

NOTE: Not more than 4 corners, all in the same town and range, may be recorded
on this certificate.

A. Description of original monument and accessories and/or subsequent restoration:

1837 GLO Not set

P.A. 345 1990 KENT COUNTY

PEER APPROVED 11/17/94

CHAIRMAN Harry Stuber

B. Description of corner evidence found and/or method applied in restoring or reestablishing corner:

Found Concrete Monument at the Northeast corner (East line of Plat) of "Indian Village
No. 4" (Liber 61 of Plats, Page 9). Said Concrete Monument is 656.53' East of the C 1/4
corner of Sec. 9, T6N, R11W and on E-W 1/4 line per plat.


E 1/4 corner Sec. 9 (Kent Co. Mon.) is East 1970.17' (1970.51' Plat)

SEE LCRC # 8803 for information on C 1/4 corner.

C. Description of monument for corner and accessories established to perpetuate locating the position of the corner:

Set Standard Kent Co. Witness Monument in place of Concrete Monument

SW face of chain link fence post	N45°E	0.95'
Set Nail & KC Remon. tag W. side 24" Oak	S15°W	20.75'
Set Nail & KC Remon. tag N. side 36" Oak	S70°W	23.64'
Set Nail & KC Remon. tag NW side 6" Maple	N30°E	17.66'
Set Nail & KC Remon. tag SW side 10" Maple	N30°W	36.59'

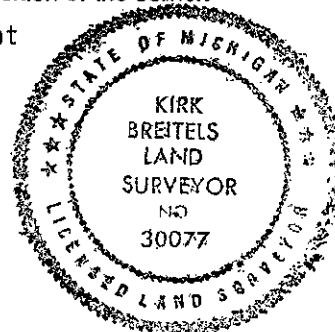

Signed by

Kirk Breitels

Date

12/11/95

Surveyor's Michigan License No.

30077