

7/2 SURVEY & REMONUMENTATION

OCT 28 1994

KENT COUNTY REMONUMENTATION

ADA TWP.

COMMISSION

LAND CORNER RECORDATION CERTIFICATE

Filing Requirement of Act 74, Mich. P.A. 1970

STATE OF MICHIGAN
COUNTY OF KENT
RECEIVED FOR RECORD

94 JUL -5 PM 3:12

For corners in
KENT COUNTY
(County)

Located In:

Corner Code ##

1. Public Land Survey

T _____ R _____
T _____ R _____
T _____ R _____
T _____ R _____

Other Code

2. Property Controlling
in Section

S 35 T 7N R 10W
S _____ T _____ R _____

Wit. Mon. on
on W. line

3. Miscellaneous
Property in Sec.

S _____ T _____ R _____
S _____ T _____ R _____

Sec. 35

SURVEY & Register of Deeds Stamp & File Number

REMONUMENTATION

REG. OF DEEDS

6956

4. Lot No. _____, Recorded Plat _____
5. Private Claims _____

MAY 09 1996

COMMISSION

I, William R. Byl, in a field survey on Feb. 18, 1994

do hereby certify that under requirements of P.A. 74, Michigan P.A. of 1970, the corner points mentioned in lines 1 and 2 above were in conformance with regulations and rules therefore as required in the current manual of survey instructions of the United States Department of the Interior, Bureau of Land Management or by a decree of a Court of Law and/or that the corner points mentioned in lines 3, 4 and 5 above were in conformance with the rules of the Michigan Board of Land Surveyors or by a Decree of a Court of Law; established, re-established, monumented, re-monumented, recovered, found as expressed below:

NOTE: Not more than 4 corners, all in the same town and range, may be recorded on this certificate.

A. Description of original monument and accessories and/or subsequent restoration:

Post set at meander corner on left side of Grand River per GLO survey

No other information available from the County Surveyor's Office, other surveying firms or any other sources.

P.A. 345 1990 KENT COUNTY
PEER APPROVED 3/24/94
CHAIRMAN

B. Description of corner evidence found and/or method applied in restoring or reestablishing corner:

Did not find meander corner as set per GLO survey


No evidence of occupation or corner, set Kent County Reference Monument on line between W 1/4 corner and NW corner of Section 35.

Corner "B" on recorded survey of Sec. 35-7-10
Recorded survey 2265 P20

C. Description of monument for corner and accessories established to perpetuate locating the position of the corner:

Kent County Reference Monument
Set Nail & KC Remon. tag W. side 24" Maple
Set Nail & KC Remon. tag W. side 12" Ash
Set Nail & KC Remon. tag W. side 12" Ash
Set Nail & KC Remon. tag N. side 12" Ash
SW'ly bank of the Grand River is North 50' m/1

N20°W 35.52'
N50°E 16.73'
S10°E 43.51'
S75°W 13.52'

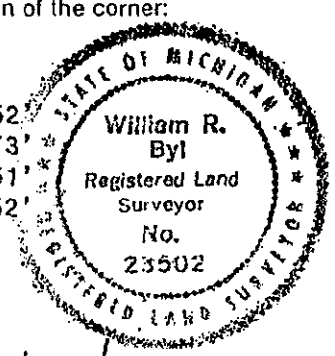

Signed by William R. Byl
Surveyor's Michigan License No. 23502

Date 06/27/94