

KENT COUNTY REMONUMENTATION

LAND CORNER RECORDATION CERTIFICATE

Filing Requirement of Act 74, Mich. P.A. 1970

ADA TOWNSHIP

For corners in
KENT COUNTY

(County)

Located In:

Corner Code ##

1. Public Land Survey

T	_____	R	_____
T	_____	R	_____
T	_____	R	_____
T	_____	R	_____
2. Property Controlling
in Section

S	28	T	7	R	10	Wit. Mon. on
S	_____	T	_____	R	_____	on N. line
3. Miscellaneous
Property in Sec.

S	_____	T	_____	R	_____	Sec. 28
S	_____	T	_____	R	_____	

STATE OF MICHIGAN
COUNTY OF KENT
RECEIVED FOR RECORD

94 JAN -5 AM 11:45

Prop Control

REG. OF DEEDS # 8

6866

Register of Deeds Stamp & File Number

4. Lot No. _____, Recorded Plat _____
5. Private Claims _____

I, William R. Byl, in a field survey on Dec. 28, 19 93, do hereby certify that under requirements of P.A. 74, Michigan P.A. of 1970, the corner points mentioned in lines 1 and 2 above were in conformance with regulations and rules therefore as required in the current manual of survey instructions of the United States Department of the Interior, Bureau of Land Management or by a decree of a Court of Law and/or that the corner points mentioned in lines 3, 4 and 5 above were in conformance with the rules of the Michigan Board of Land Surveyors or by a Decree of a Court of Law; established, re-established, monumented, re-monumented, recovered, found as expressed below:

NOTE: Not more than 4 corners, all in the same town and range, may be recorded on this certificate.

A. Description of original monument and accessories and/or subsequent restoration:

Post set at meander corner on right side of Grand River per GLO survey

B. Description of corner evidence found and/or method applied in restoring or reestablishing corner:


Did not find meander corner as set per GLO survey

Set Reference Point of East side of Grand River on straight line between N 1/4 and NW corners of Section 28. No evidence of occupation on either side of river. Common ownership across Section line on each side of river.

C. Description of monument for corner and accessories established to perpetuate locating the position of the corner:

Kent County Reference Monument

Nail & KC remon. tag NE side 12" Ash	N40°W	45.65'
Nail & KC remon. tag S. side 20" Oak	N65°E	18.53'
Nail & KC remon. tag W. side 30" Oak	S00°E	52.31'
Nail & KC remon. tag S. side 12" Ash	S65°E	22.88'
East bank of Grand River	West	170'

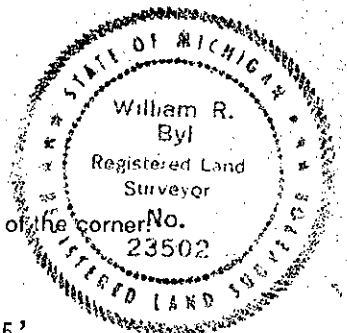

Signed by

Date

12-27-93

Surveyor's Michigan License No.

23502

Note: See Survey L258 P47 for map