

KENT COUNTY REMONUMENTATION

LAND CORNER RECORDATION CERTIFICATE
Filing Requirement of Act 74, Mich. P.A. 1970

STATE OF MICHIGAN
COUNTY OF KENT
RECEIVED FOR RECORD

94 JAN -5 AM 11:45

For corners in
KENT COUNTY

ADA TOWNSHIP

Located In:

Corner Code #

1. Public Land Survey	T	R	
	T	R	
	T	R	
	T	R	
2. Property Controlling in Section	S 27	T 7	R 10
	S	T	R
3. Miscellaneous	S	T	R
Property in Sec.	S	T	R

Wit. Mon. on
E&W 1/4 line
Sec. 27

Prop Control
G. OF DEEDS
Other Code #9
6870

Register of Deeds Stamp & File Number

4. Lot No. _____, Recorded Plat _____
5. Private Claims _____

	A	B	C	D	E	F	G	H	I	J	K	L	M
2	6		5		4		3		2		1		
3													
4	7		8		9		10		11		12		
5													
6	10		17		16		15		14		13		
7													
8	19		20		21		22		23		24		
9													
10	30		29		28		27		26		25		
11													
12	31		32		33		34		35		36		
13													

I, William R. Byl, in a field survey on Dec. 28, 19 93, do hereby certify that under requirements of P.A. 74, Michigan P.A. of 1970, the corner points mentioned in lines 1 and 2 above were in conformance with regulations and rules therefore as required in the current manual of survey instructions of the United States Department of the Interior, Bureau of Land Management or by a decree of a Court of Law and/or that the corner points mentioned in lines 3, 4 and 5 above were in conformance with the rules of the Michigan Board of Land Surveyors or by a Decree of a Court of Law; established, re-established, monumented, re-monumented, recovered, found as expressed below:

NOTE: Not more than 4 corners, all in the same town and range, may be recorded on this certificate.

A. Description of original monument and accessories and/or subsequent restoration:

No evidence or record of corner ever set.

B. Description of corner evidence found and/or method applied in restoring or reestablishing corner:


Set reference point on East and West 1/4 line East of the Grand River. Point set on a line parallel with the North Sec. line, running West from the Central 1/4 corner. Agrees with 1938 Williams & Works survey. No occupation evidence along line.

C. Description of monument for corner and accessories established to perpetuate locating the position of the corner:

Kent County Reference Monument

Set Nail & KC Remon. tag W. side Tele. Pole
Set Nail & KC Remon. tag E. side 16" Oak
Set Nail & KC Remon. tag N. side 16" Hickory
NW corner of Park Bldg.
C/L Pettis Ave.
East bank of the Grand River

N00°E 89.61'
S20°E 44.12'
S65°W 41.90'
S15°E 165.65'
NE 19'
West 160'

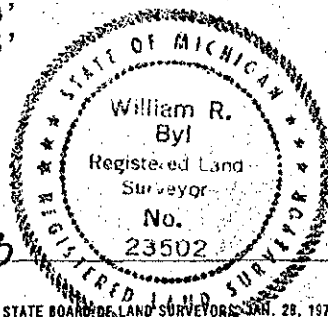

Signed by William R. Byl
Surveyor's Michigan License No. 23502

Date 12.27.93

Note: See Survey L 258 P 46 for map