

## KENT COUNTY REMONUMENTATION

ADA TWP.

STATE OF MICHIGAN  
COUNTY OF KENT  
RECEIVED FOR RECORDLAND CORNER RECORDATION CERTIFICATE  
Filing Requirement of Act 74, Mich. P.A. 1970

94 JUL -5 PM 3:12

For corners in  
KENT COUNTY  
(County)

Located In:

Corner Code =#

1. Public Land Survey

T \_\_\_\_\_ R \_\_\_\_\_  
T \_\_\_\_\_ R \_\_\_\_\_  
T \_\_\_\_\_ R \_\_\_\_\_  
T \_\_\_\_\_ R \_\_\_\_\_2. Property Controlling  
in SectionS 35 T 7N R 10W  
S \_\_\_\_\_ T \_\_\_\_\_ R \_\_\_\_\_3. Miscellaneous  
Property in Sec.S \_\_\_\_\_ T \_\_\_\_\_ R \_\_\_\_\_  
S \_\_\_\_\_ T \_\_\_\_\_ R \_\_\_\_\_Wit. Mon. on \_\_\_\_\_  
on S. line \_\_\_\_\_  
Sec. 35 \_\_\_\_\_Prop Control  
other code #12  
6954

Register of Deeds Stamp &amp; File Number

4. Lot No. \_\_\_\_\_, Recorded Plat \_\_\_\_\_

5. Private Claims \_\_\_\_\_

I, William R. Byl, in a field survey on Feb. 18, 19 94,  
do hereby certify that under requirements of P.A. 74, Michigan P.A. of 1970, the corner points mentioned  
in lines 1 and 2 above were in conformance with regulations and rules therefore as required in the  
current manual of survey instructions of the United States Department of the Interior, Bureau of Land  
Management or by a decree of a Court of Law and/or that the corner points mentioned in lines 3, 4 and 5  
above were in conformance with the rules of the Michigan Board of Land Surveyors or by a Decree of a  
Court of Law; established, re-established, monumented, re-monumented, recovered, found as  
expressed below:

NOTE: Not more than 4 corners, all in the same town and range, may be recorded  
on this certificate.

A. Description of original monument and accessories and/or subsequent restoration:

Post set at meander corner on left side of Grand River per GLO survey

No other information available from the County Surveyor's Office, other surveying  
firms or any other sources.

P.A. 345 1990 KENT COUNTY

PEER APPROVED 3/24/94CHAIRMAN Harry Ruben

B. Description of corner evidence found and/or method applied in restoring or reestablishing corner:

Did not find meander corner as set per GLO survey

Found E-W fence line on West bank of the Grand River to be on line more or less with the  
SW and SE corners of Section 35. Set Kent County Reference Monument on a straight line  
between the SW and SE corners of Section 35.

Corner "D" on recorded survey of Sec. 35-7-10

Recorded survey L 265 P 20

C. Description of monument for corner and accessories established to perpetuate locating the position of the corner:

## Kent County Reference Monument

Nail &amp; KC Remon. tag S. side 15" Thornapple

Nail &amp; KC Remon. tag N. side 8" Ash

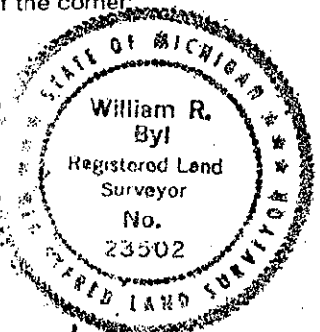
Nail &amp; KC Remon. tag NW side 12" Ash

Nail &amp; KC Remon. tag E. side 20" Ash

Top of bank is East 20'

SW'ly bank of the Grand River is East 35' m/l

E-W fence is South 1'

N70°W 55.70'  
S90°W 34.83'  
S50°W 71.00'  
S10°E 59.13'

Signed by

Date

Surveyor's Michigan License No. 23502FORM APPROVED BY MICHIGAN STATE BOARD OF LAND SURVEYORS, JAN. 28, 1971  
REVISED MAY 14, 1975  
REVISED JAN., 1993