

\$7.00
\$2.00

LAND CORNER RECORDATION CERTIFICATE
Filing Requirement of Act 74, Mich. P.A. 1970
KENT COUNTY REMONUMENTATION

For corners in

Kent
(County)

Located in:

Corner Code #

1. Public Land Survey

T _____ R _____

Reference Monument

T _____ R _____

950.45' South of G-10

T _____ R _____

T _____ R _____

2. Property Controlling
in Section

S _____ T 7N R 11W

S _____ T _____ R _____

3. Miscellaneous
Property in Sec.

S _____ T _____ R _____

S _____ T _____ R _____

4. Lot No. _____, Recorded Plat _____

5. Private Claims _____

I, Randy Kolehouse, in a field survey on December 6 19 95,
do hereby certify that under requirements of P.A. 74-Michigan P.A. of 1970, the corner points
mentioned in lines 1 and 2 above were in conformance with regulations and rules therefore as required
in the current manual of survey instructions of the United States Department of the Interior, Bureau of
Land Management or by a decree of a Court of Law and/or that the corner points mentioned in lines 3,
4 and 5 above were in conformance with the rules of the Michigan Board of Land Surveyors or by a
Decree of a Court of Law; established, re-established, monumented, re-monumented, recovered,
found as expressed below:

NOTE: Not more than 4 corners, all in the same town and range, may be recorded
on this certificate.

A. Description of original monument and accessories and/or subsequent restoration:

G-10 This corner was not originally set by the G.L.O.

	A	B	C	D	E	F	G	H	I	J	K	L	M
2	6	5	4	3	2	1							
3													
4	7	8	9	10	11	12							
5													
6	13	14	15	16	17	18							
7													
8	19	20	21	22	23	24							
9													
10	25	26	27	28	29	30							
11													
12	31	32	33	34	35	36							
13													

P.A. 345 1990 KENT COUNTY

PEER APPROVED 11/17/94

CHAIRMAN Harry Huber


B. Description of corner evidence found and/or method applied in restoring or reestablishing corner:

G-10 Set point on Section line between Sections 27 and 28 using the Kent County Monument at G-10 and 33.0 feet from right-of-way irons found along Maryland Avenue. This point is 1,696.29 feet North of the calculated location of G-11 (corner falls in Reeds Lake). Calculated distance G-10 - G-11 = 2,646.74 feet (G.L.O. = 2,640.0').

C. Description of monument for corner and accessories established to perpetuate locating the position of the corner:

G-10 Set Reference Monument (Standard Kent County Monument) 950.45 feet South of G-10.

Nail & K.C. remon. tag in SE side P. pole N 17° E 127.63'
Nail & K.C. remon. tag in NW side P. pole S 71° W 90.13'
Nail & K.C. remon. tag in N side Trip. 10" Maple N 86° W 116.95'
Nail & K.C. remon. tag in SW side 28" Walnut N 45° W 54.73'
C/L top fire hydrant East 19.77'
8' M/L South of South edge pavement Robinson Road

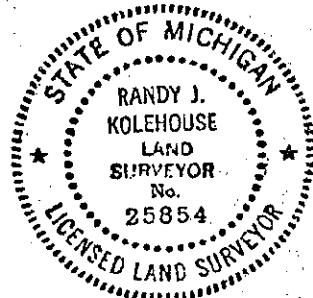

Signed by Randy J. Kolehouse

EARTH TECH

Date 12/22/95

Surveyor's Michigan License No. 25854