

93 MAY 13 AM 9:07

Kent County Remonumentation
LAND CORNER RECORDATION CERTIFICATE
Filing Requirement of Act 74, Mich. P.A. 1970

For corners in

Kent
(County)Located In:
Grattan Twp.

Corner Code #

1. Public Land Survey

T 8-N R 9-W

D-5 Witness

T R

T R

T R

2. Property Controlling
in Section

S 8 T 8-N R 9-W

West of D-5

S 17 T 8-N R 9-W

West side of

3. Miscellaneous
Property in Sec.

S T R

Toohey Lake

S T R

on Sec. Line.

REG. OF DEEDS

6776

Register of Deeds Stamp & File Number

4. Lot No. , Recorded Plat

5. Private Claims

I, Thomas Starr, in a field survey on March 15, 19 93, do hereby certify that under requirements of P.A. 74, Michigan P.A. of 1970, the corner points mentioned in lines 1 and 2 above were in conformance with regulations and rules therefore as required in the current manual of survey instructions of the United States Department of the Interior, Bureau of Land Management or by a decree of a Court of Law and/or that the corner points mentioned in lines 3, 4 and 5 above were in conformance with the rules of the Michigan Board of Land Surveyors or by a Decree of a Court of Law; established, re-established, monumented, re-monumented, recovered, found as expressed below:

NOTE: Not more than 4 corners, all in the same town and range, may be recorded on this certificate.

A. Description of original monument and accessories and/or subsequent restoration:

D-5

Falls in Toohey Lake
GLO offset around lake with no points set,
Corner location established by Moore & Bruggink - 1972
Survey - Recorded - Liber 1, Page 50.

B. Description of corner evidence found and/or method applied in restoring or reestablishing corner:

Re-established corner location and found iron
West of Toohey Lake per 1972 Recorded Survey.

For Section 8 - Sectional Survey
See Recorded Survey - Liber 253, Page 44.

For Section 17 - Sectional Survey
See Recorded Survey - Liber 253, Page 43.

C. Description of monument for corner and accessories established to perpetuate locating the position of the corner:

Replaced iron with Standard Kent County Monument with witness cap - 999.83'
West of South 1/4 corner Section 8, witness

Nail & Tag in S. side 30" Oak

N72°W 9.66'

Nail & Tag in W. side 10" Oak

N32°W 3.35'

Nail & Tag in E. side 12" Maple

N54°E 3.45'

Nail & Tag in N. side 10" Maple

S88°E 10.95'

Nail & Tag in E. side 12" Triple Maple

S40°E 29.65'

Nail & Tag in E. side 10" Quad. Beech

S05°E 4.83'

East & West Fence Line - 1' North
on East & West Wood Line

Signed by Thomas C. StarrDate 5-11-93Surveyor's Michigan License No. 25874

Project No. 92035

Date: 3-24-93

For: K.C. REMONUMENTATION

State of Michigan.


Kent County Register of Deeds

This survey was received for record

on the 13th day of May, 1993 at 11 A. M

Recorded in Liber 253 of surveys Page 44

SECTION 8
T-8-N, R-9-W
GRATTON TWP.

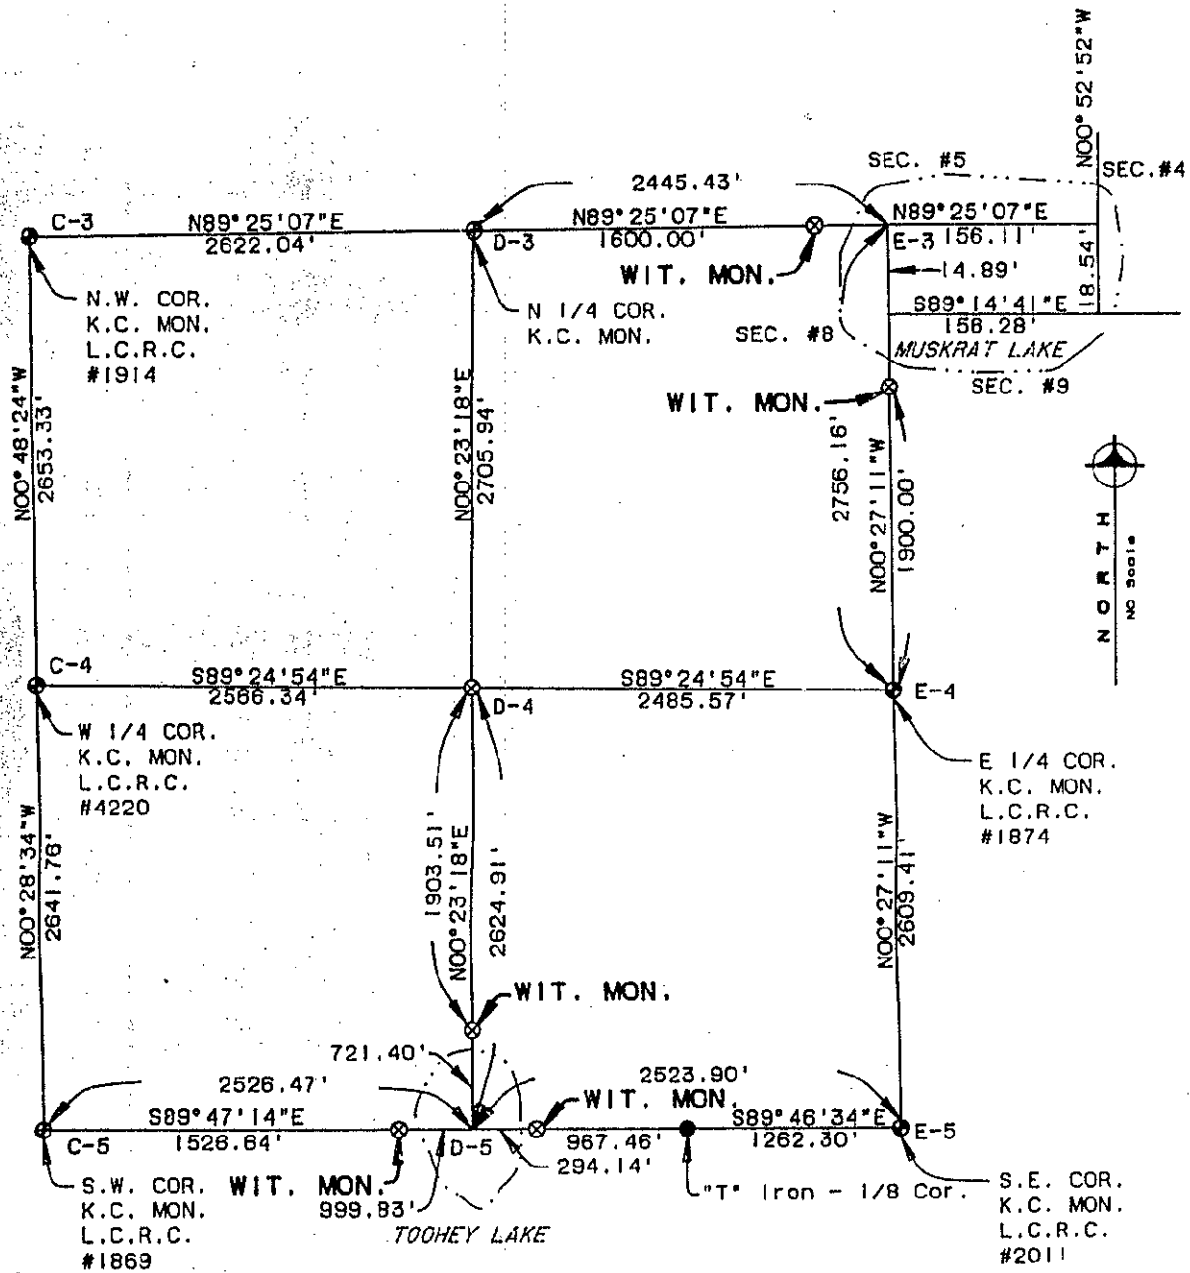

Note: All Bearings Based on Solar Observation

I HEREBY CERTIFY THAT THIS SURVEY MEETS ALL OF THE REQUIREMENTS OF P.A. 132-1978.

LEGEND

- IRON STAKE (FOUND)
- ⊗ MONUMENT (SET)
- ⊙ MONUMENT
- WOOD STAKE
- X FENCE LINE
- R RECORDED DIMENSION
- D DEED DIMENSION
- H MEASURED DIMENSION
- E CENTER LINE



omm engineering, inc.
civil engineers/surveyors
1550 east beltline, s.e.
grand rapids, mi. 49506
616-957-4350



Thomas C. Starr


THOMAS C. STARR
Registered Land Surveyor
No. 25874

For: K.C. REMONUMENTATION

This survey was received for record
on the 13th day of May, 1993 at 11 A.M



Recorded in Liber 262 of surveys Page 447.

Gratton Twp.

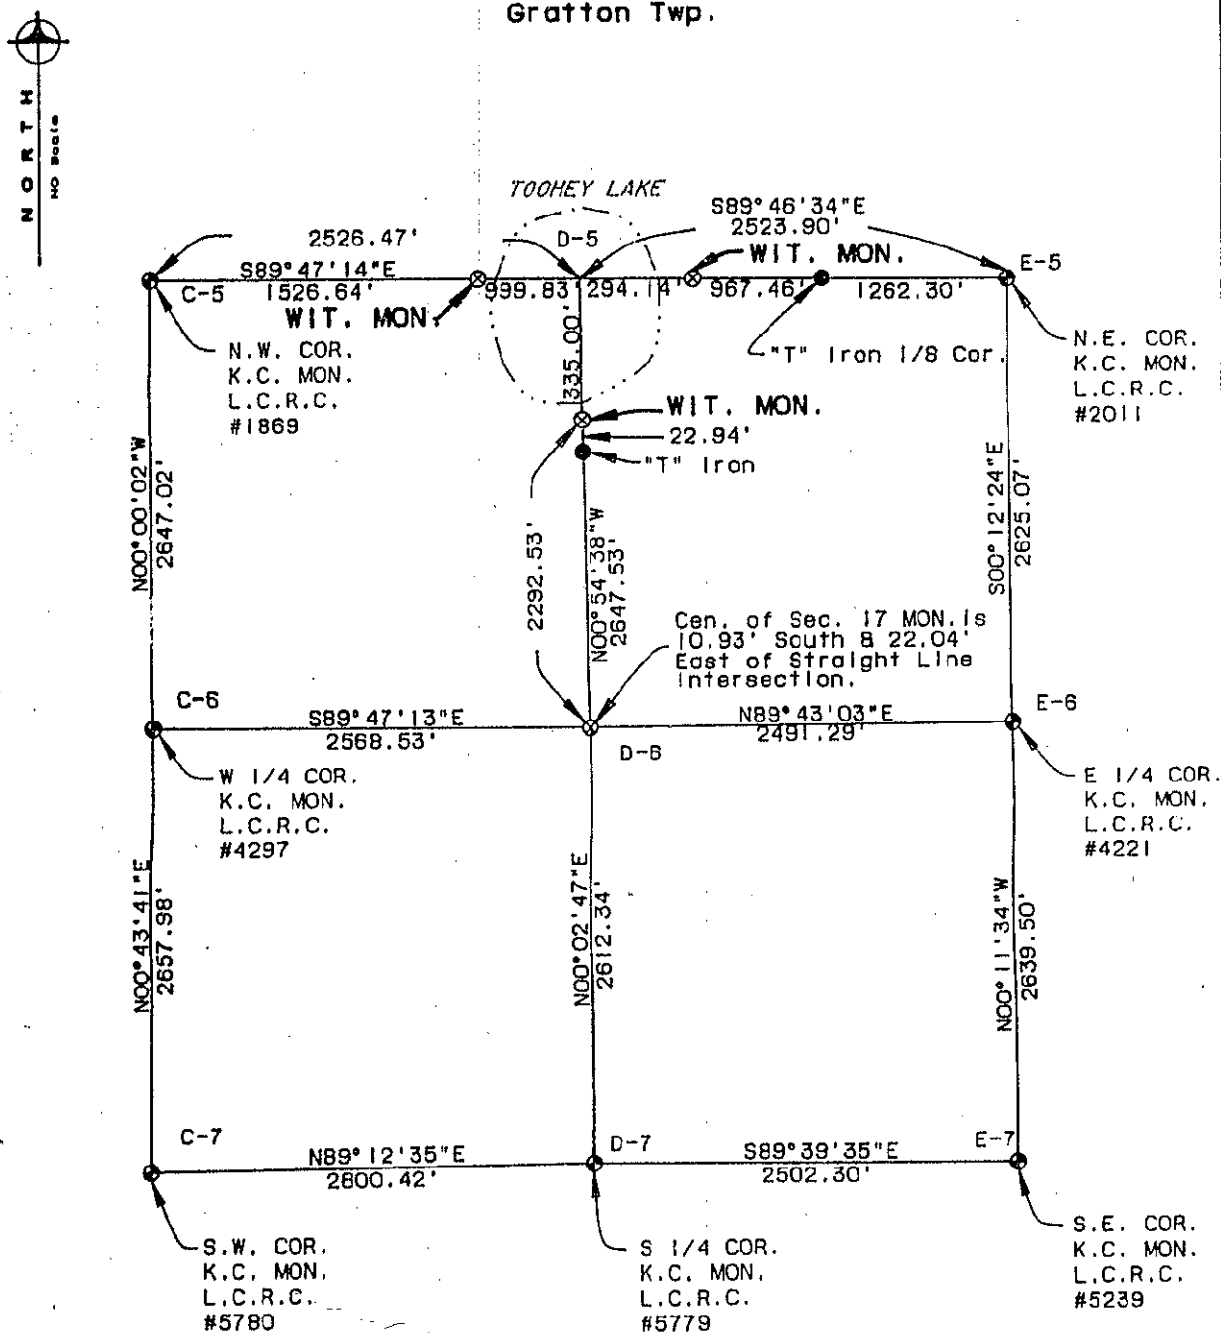

I HEREBY CERTIFY THAT THIS SURVEY MEETS ALL OF THE REQUIREMENTS OF P.A. 132-1978.

- IRON STAKE(FOUND)
- ⊕ MONUMENT (SET)
- ⊙ MONUMENT
- WOOD STAKE
- X FENCE LINE
- R RECORDED DIMENSION
- D DEED DIMENSION
- M MEASURED DIMENSION
- C CENTER LINE

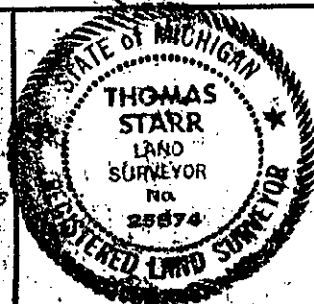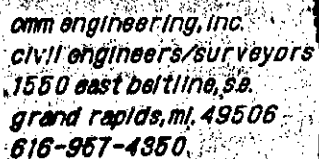

Thomas C. Swan

THOMAS C. STARR
Registered Land Surveyor
No. 25874