

Kent County Remonumentation
LAND CORNER RECORDATION CERTIFICATE 93 MAY 13 AM 9:07
Filing Requirement of Act 74, Mich. P.A. 1970

For corners in

Kent
(County)Located In:
Grattan Twp.

Corner Code ##

1. Public Land Survey

T 8-N R 9-W

E-3 Witness

T _____ R _____

T _____ R _____

T _____ R _____

2. Property Controlling
in SectionS 5 T 8-N R 9-W

West of E-3

S 8 T 8-N R 9-W

West side of

3. Miscellaneous
Property in Sec.

S _____ T _____ R _____

Muskrat Lake

S _____ T _____ R _____

On E. & W. Sec. Line.

REG. OF DEEDS

6779

Register of Deeds Stamp & File Number

4. Lot No. _____, Recorded Plat _____

5. Private Claims _____

I, Thomas Starr, in a field survey on March 15, 19 93

do hereby certify that under requirements of P.A. 74, Michigan P.A. of 1970, the corner points mentioned in lines 1 and 2 above were in conformance with regulations and rules therefore as required in the current manual of survey instructions of the United States Department of the Interior, Bureau of Land Management or by a decree of a Court of Law and/or that the corner points mentioned in lines 3, 4 and 5 above were in conformance with the rules of the Michigan Board of Land Surveyors or by a Decree of a Court of Law; established, re-established, monumented, re-monumented, recovered, found as expressed below:

NOTE: Not more than 4 corners, all in the same town and range, may be recorded on this certificate.

A. Description of original monument and accessories and/or subsequent restoration:

E-3

Falls in Muskrat Lake

GLO traversed around lake with meander corners.

	A	B	C	D	E	F	G	H	I	J	K	L	M
2	6	5	4	3	2	1							
3													
4	7	8	9	10	11	12							
5													
6	18	17	16	15	14	13							
7													
8	19	20	21	22	23	24							
9													
10	30	29	28	27	26	25							
11													
12	31	32	33	34	35	36							
13													

B. Description of corner evidence found and/or method applied in restoring or reestablishing corner:

Established South line of Section 5 by holding straight line from C-3 through D-3 East to Muskrat Lake

For Section 5 - Sectional Survey

See Recorded Survey - Liber 253, Page 41.

For Section 8 - Sectional Survey

See Recorded Survey - Liber 253, Page 44.

C. Description of monument for corner and accessories established to perpetuate locating the position of the corner:

Set Standard Kent County Monument with witness cap - 1600' East of D-3

Witness

Nail & Tag in S. side of Power Pole

Nail & Tag in E. side of 20" Maple

Nail & Tag in N. side of 16" Oak

N.E. Corner Building

N.E. Corner Building

East and West fence line - South 1'

S90°W	3.51'
S35°E	3.12'
S55°E	9.67'
S40°W	3.53'
S60°E	21.49'

Signed by

Thomas C. Starr

Date

5-11-93Surveyor's Michigan License No. 25874

Project No. 92035

Date: 3-24-93

For: K.C. REMONUMENTATION

State of Michigan,

Kent County Register of Deeds

This survey was received for record


on the 13th day of May, 1993 at 11 A.M.

Recorded in Liber 253 of surveys Page 41

Section 5

T-8-N, R-9-W

Grafton Twp.

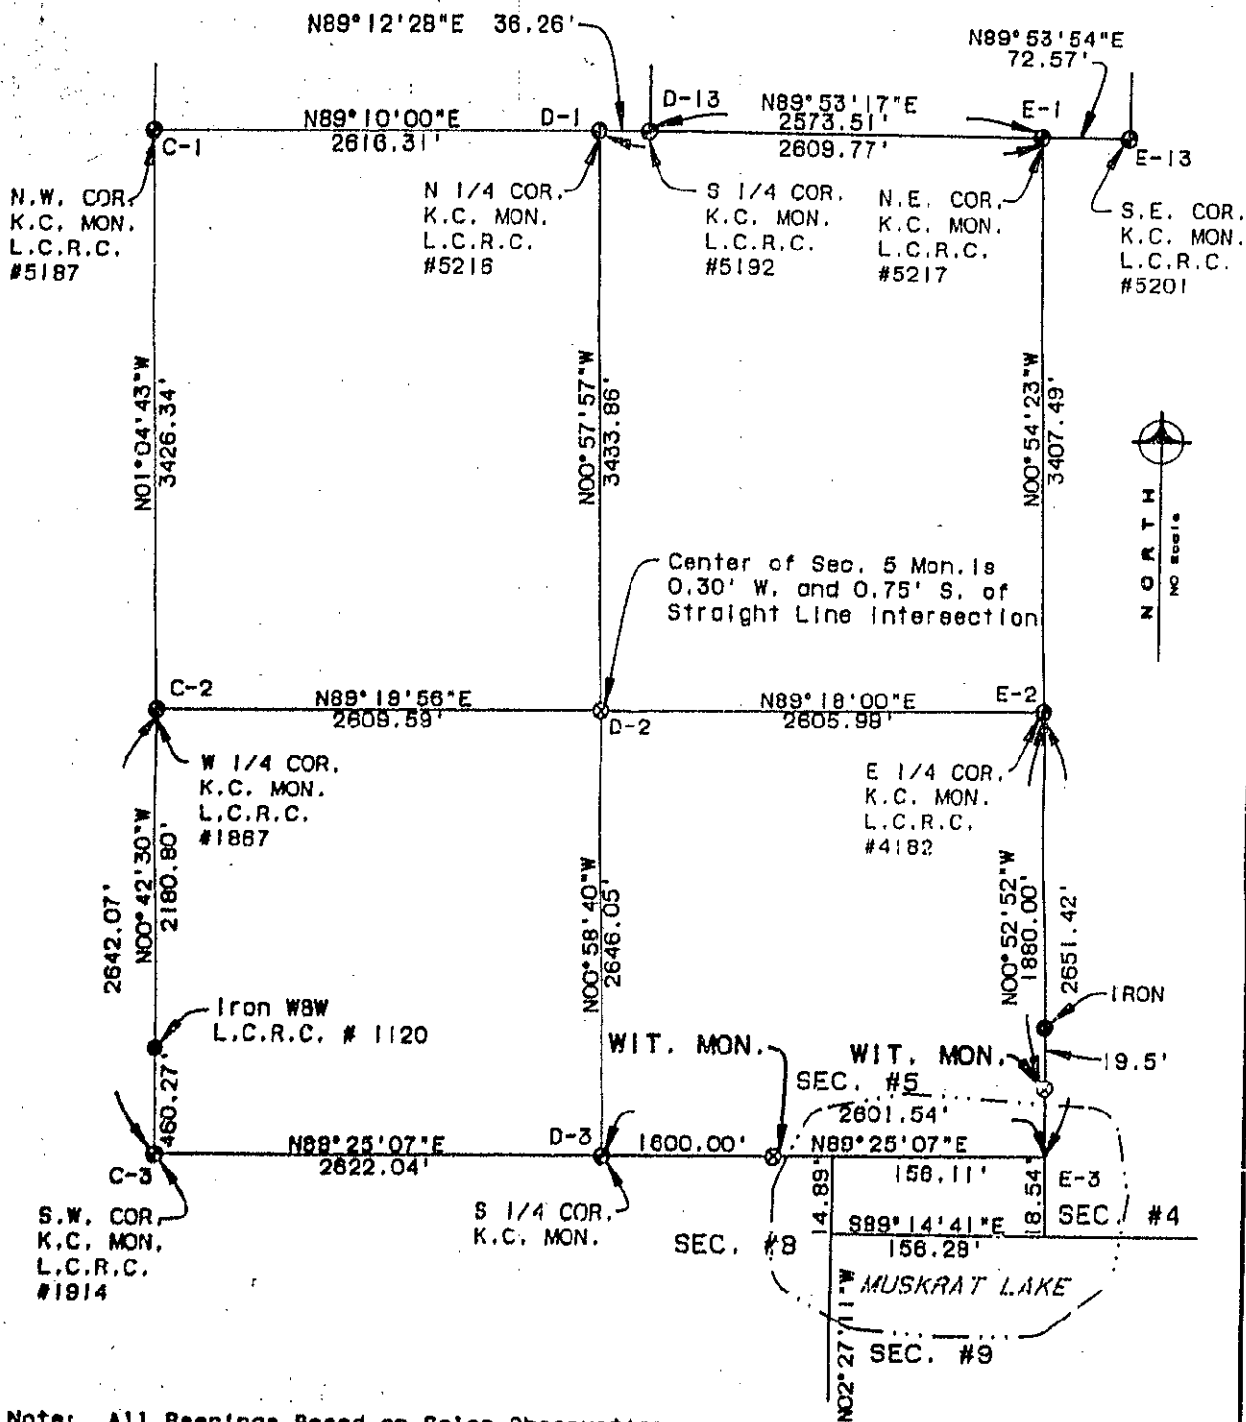

Note: All Bearings Based on Solar Observation


I HEREBY CERTIFY THAT THIS SURVEY MEETS ALL OF THE REQUIREMENTS OF P.A. 132-1979.

LEGEND

- IRON STAKE (FOUND)
- MONUMENT (SET)
- MONUMENT
- WOOD STAKE
- X- FENCE LINE
- R RECORDED DIMENSION
- D DEED DIMENSION
- M MEASURED DIMENSION
- E CENTER LINE



oma engineering, inc.
civil engineers/surveyors
1550 east beltline, s.e.
grand rapids, mi. 49506
616-957-4350

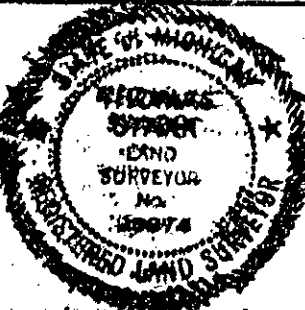

Thomas C. Starr

THOMAS C. STARR
Registered Land Surveyor
No. 25874

Project No. 92035

Date: 3-24-93


For: K.C. REMONUMENTATION

State of Michigan,
Kent County Register of Deeds

This survey was received for record
on the 13th day of May, 1993 at 11 A. M.

Recorded in Liber 253 of surveys Page 44.

SECTION 8
T-8-N, R-9-W
GRATTON TWP.

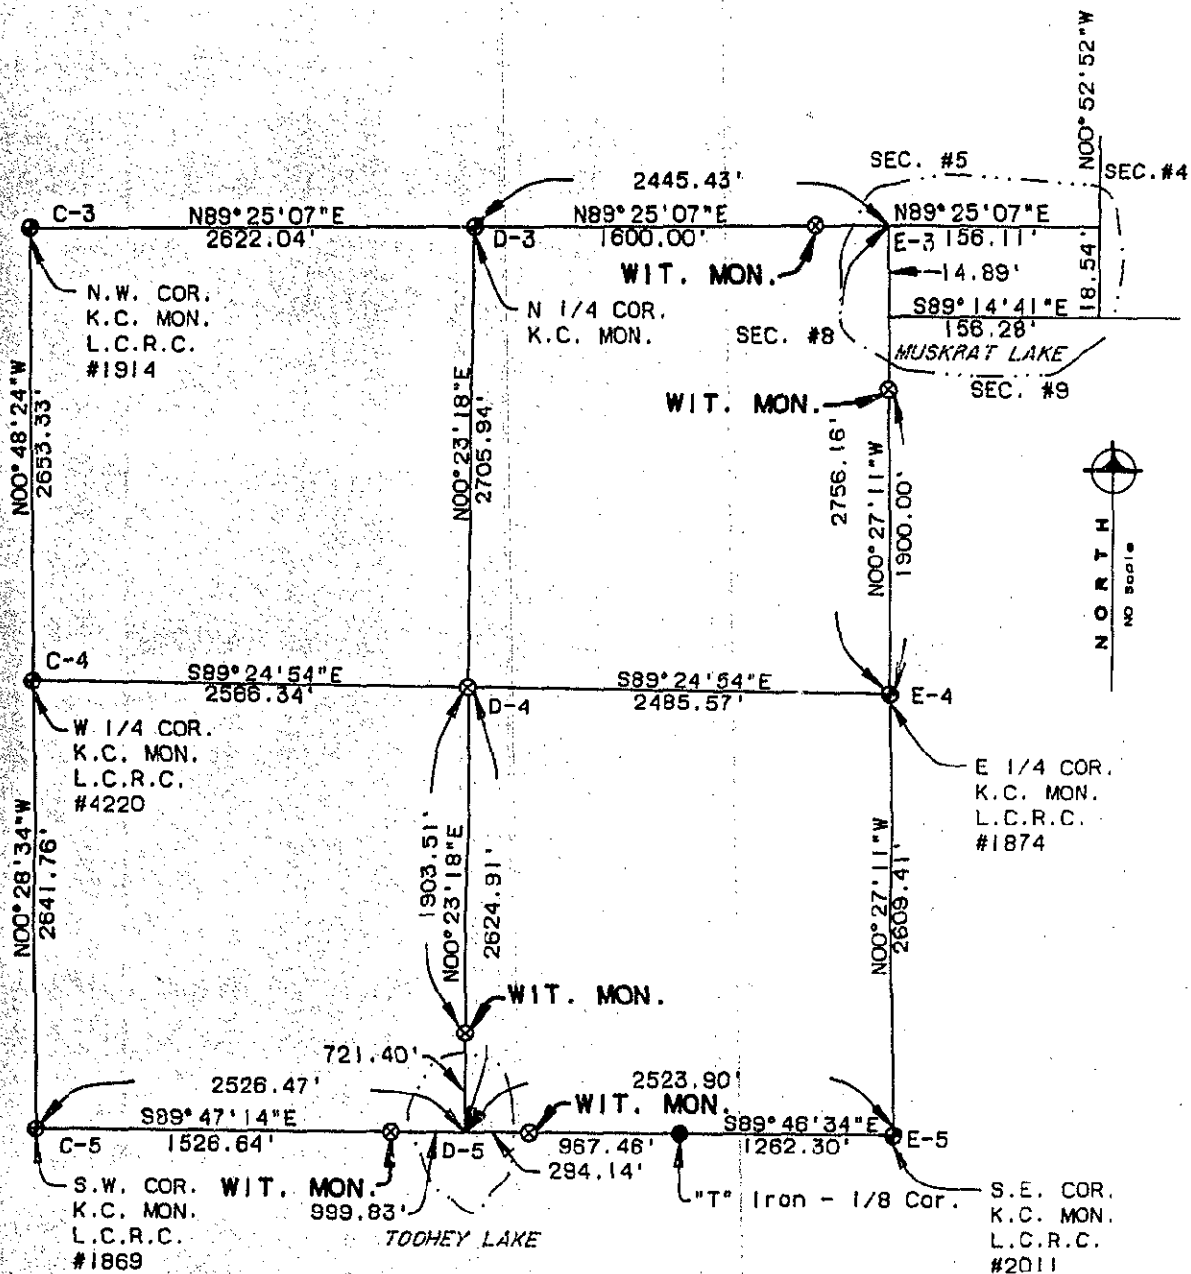

Note: All Bearings Based on Solar Observation

I HEREBY CERTIFY THAT THIS SURVEY MEETS ALL OF THE REQUIREMENTS OF P.A. 132-1978.

LEGEND

- IRON STAKE (FOUND)
- ⊗ MONUMENT (SET)
- ⊙ MONUMENT
- WOOD STAKE
- X-FENCE LINE
- R RECORDED DIMENSION
- D DEED DIMENSION
- M MEASURED DIMENSION
- E CENTER LINE



omm engineering, inc.
civil engineers/surveyors
1550 east beltline, se
grand rapids, mi. 49506
616-957-4350



Thomas C. Starr

THOMAS C. STARR
Registered Land Surveyor
No. 25874