

KENT COUNTY REMONUMENTATION
LAND CORNER RECORDATION CERTIFICATE
Filing Requirement of Act 74, Mich. P.A. 1970
Oakfield Township

STATE OF MICHIGAN
COUNTY OF KENT
RECEIVED FOR RECORD

93 AUG 26 PM 4: 21

For corners in

Kent

(County)

Located In:

Corner Code ==

1. Public Land Survey

T R
T R
T R
T R

2. Property Controlling
in Section

S T R
S T R

3. Miscellaneous

S 28 T 9N R 9W

Witness Cor.

E.Line Sec. 28

Property in Sec.

S T R

4. Lot No. , Recorded Plat

5. Private Claims

Chris Marschall
Prop Control!
other code # 6
6825

Register of Deeds Stamp & File Number

1. Chris Marschall in a field survey on May, 19 93

do hereby certify that under requirements of P.A. 74, Michigan P.A. of 1970, the corner points mentioned in lines 1 and 2 above were in conformance with regulations and rules therefore as required in the current manual of survey instructions of the United States Department of the Interior, Bureau of Land Management or by a decree of a Court of Law and/or that the corner points mentioned in lines 3, 4 and 5 above were in conformance with the rules of the Michigan Board of Land Surveyors or by a Decree of a Court of Law; established, re-established, monumented, re-monumented, recovered, found as expressed below:

NOTE: Not more than 4 corners, all in the same town and range, may be recorded on this certificate.


	A	B	C	D	E	F	G	H	I	J	K	L	M
2	6	5	4	3	2	1							
3													
4	7	8	9	10	11	12							
5													
6	18	17	16	15	14	13							
7													
8	19	20	21	22	23	24							
9													
10	30	29	28	27	26	25							
11													
12	31	32	33	34	35	36							
13													

A. Description of original monument and accessories and/or subsequent restoration:

GLO Reduces a 35 chain offset at a point on the East line of Section 28,
16 chains S. of the section corner common to 21, 22, 27 & 28 No witnesses

B. Description of corner evidence found and/or method applied in restoring or reestablishing corner:

No evidence of any occupation. Established bearing of Section line by the mean of the E. line of Section 27 and the W. line of Section 28 and set 30" Harrison monument with witness corner cap at the South end of the East line of Section 28.

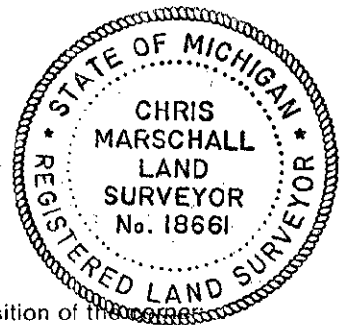

C. Description of monument for corner and accessories established to perpetuate locating the position of the corner:

Harrison Monument with witness Corner Cap

Nail and Tag in SW Side 8" Ironwood

N 70°W 21.92'

Nail and Tag in SE Side 18" Oak

N 45°E 12.27'

Nail and Tag in N Side 16" Oak

N 90°E 5.93'

Nail and Tag in W Side 22" Beech

S 20°E 32.18'

North edge of swamp

South 65' more or less

Angle point in boat landing lane (approx. 250' S. of lake)

West 100' more or less

The ground located 20' North, East and West is 2 to 3' above the monument elevation

Monument is 15' more or less above the swamp elevation and about 0.2' above grade

See Other Side for Sketch

Signed by Chris Marschall

Date May 1993

Surveyor's Michigan License No. 18661

Register of deeds, County of _____
This survey was _____ and for record on the _____
of _____ 19 _____ at _____ M. recorded in Liber _____
of Surveyors Page _____

6825 B