

# SURVEY & REMONUMENTATION

\$7.00  
\$2.00

MAY 22 2000

## SECTION

## LAND CORNER RECORDATION CERTIFICATE Filing Requirement of Act 74, Mich. P.A. 1970 KENT COUNTY REMONUMENTATION

For corners in

Kent  
(County)

Located in: Oakfield  
Township

Corner Code #

1. Public Land Survey	T	9N	R	9W	Ref. Mon.
	T		R		1344.3' +/-
	T		R		South of D-2
	T		R		
2. Property Controlling in Section	S		T	R	
	S		T	R	
3. Miscellaneous	S		T	R	
Property in Sec.	S		T	R	

4. Lot No. \_\_\_\_\_, Recorded Plat \_\_\_\_\_  
5. Private Claims \_\_\_\_\_

I, Randy Kolehouse, in a field survey on December 16 19 99, do hereby certify that under requirements of P.A. 74 Michigan P.A. of 1970, the corner points mentioned in lines 1 and 2 above were in conformance with regulations and rules therefore as required in the current manual of survey instructions of the United States Department of the Interior, Bureau of Land Management or by a decree of a Court of Law and/or that the corner points mentioned in lines 3, 4 and 5 above were in conformance with the rules of the Michigan Board of Land Surveyors or by a Decree of a Court of Law; established, re-established, monumented, re-monumented, recovered, found as expressed below:

**NOTE:** Not more than 4 corners, all in the same town and range, may be recorded on this certificate.

A. Description of original monument and accessories and/or subsequent restoration:

D-2 This corner was not originally set by the G.L.O.

1995 Survey Records M. Rosema Set Iron in Swamp at Intersection of 1/4 Lines

B. Description of corner evidence found and/or method applied in restoring or reestablishing corner:

D-2 The iron as set by true line (Rosema) is in an inaccessible swamp. Calculated distance from intersection of 1/4 lines to opposite 1/4 corner checks very close to true line record distance to iron set at intersection of 1/4 lines. Set a reference monument on the North-South 1/4 line 4' North of the C/L of the railroad bed, on line of an old fence running North.

Calc. 2885.99 D-2 to D-1  
Calc. 2638.14 D-2 to C-2  
Calc. 2638.54 D-2 to D-3 (true line) 2638.58  
Calc. 2635.41 D-2 to C-2 (true line) 2635.37

P.A. 345 1990 KENT COUNTY

PEER APPROVED 12/2/99


CHAIRMAN Randy Kolehouse

The selected location is accepted by me and is generally accepted by professional surveyors as the best available evidence of the position of the original corner.

C. Description of monument for corner and accessories established to perpetuate locating the position of the corner:

D-2 Set a Standard Kent County Reference Monument 1344.3 ± South of D-2

Nail & K.C. remon. tag on W side 8" Oak S 00° E 12.08'  
Nail & K.C. remon. tag on N side 15" Oak S 75° E 65.95'  
Nail & K.C. remon. tag on W side 12" Oak N 25° W 53.56'  
Nail & K.C. remon. tag on W side 10" Oak N 00° E 48.04'  
Nail & K.C. remon. tag on NW side 8" Maple N 40° E 60.96'  
True Line capped iron N 03° W 44.30'  
C/L of railroad bed North 4'  
On fence line running North

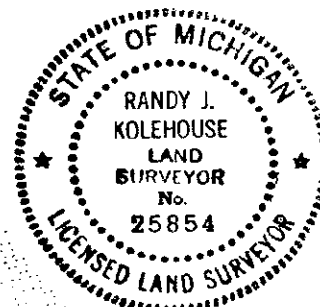

Signed by Randy J. Kolehouse

Date 12-28-99

Surveyor's Michigan License No. 25854