

SURVEY & REMONUMENTATION

\$7.00
\$2.00

MAY 22 2000

"other" #15

LAND CORNER RECORDATION CERTIFICATE Filing Requirement of Act 74, Mich. P.A. 1970 KENT COUNTY REMONUMENTATION

SECTION

For corners in

Kent
(County)

Located in: Oakfield
Township

Corner Code #

1. Public Land Survey

T 9N R 9W

D-8

2. Property Controlling
in Section

S T R

3. Miscellaneous
Property in Sec.

S T R

4. Lot No. , Recorded Plat

5. Private Claims

I, Randy Kolehhouse, in a field survey on December 13 19 99, do hereby certify that under requirements of P.A. 74 Michigan P.A. of 1970, the corner points mentioned in lines 1 and 2 above were in conformance with regulations and rules therefore as required in the current manual of survey instructions of the United States Department of the interior, Bureau of Land Management or by a decree of a Court of Law and/or that the corner points mentioned in lines 3, 4 and 5 above were in conformance with the rules of the Michigan Board of Land Surveyors or by a Decree of a Court of Law; established, re-established, monumented, re-monumented, recovered, found as expressed below:

NOTE: Not more than 4 corners, all in the same town and range, may be recorded on this certificate.

A. Description of original monument and accessories and/or subsequent restoration:

D-8 This corner was not originally set by the G.L.O.

1963	Survey Records	Williams & Works	Set Iron at Intersection of 1/4 Lines
1999	Brown Lake Condo	Nederveld & Assoc.	Held Calc. Intersection of 1/4 Lines

B. Description of corner evidence found and/or method applied in restoring or reestablishing corner:

D-8 Did not find iron set in 1963 by Williams & Works. Reset D-8 at the intersection of 1/4 lines, which checks survey records of Williams & Works and Nederveld & Associates.

Meas. from D-8 to D-7 2668.27' (Williams & Works 2668.9', N/A 2668.33')
D-8 to E-8 2627.27' (N/A 2627.20')
D-8 to D-9 2650.87' (Williams & Works 2652.0', N/A 2650.58')
D-8 to C-8 2630.11' (Williams & Works 2631.22', N/A 2630.12')

This corner falls in a swamp. Set reference monuments North and West of corner.

The selected location is accepted by me and is generally accepted by professional surveyors as the best available evidence of the position of the original corner.

C. Description of monument for corner and accessories established to perpetuate locating the position of the corner:

D-8 Set a Kent County Reference Monument West 125.42'

Set a Kent County Reference Monument North 106.78'

Nail & K.C. remon. tag on NE side 30" Oak N 60° W 9.53'
Nail & K.C. remon. tag on E side 12" Oak N 10° E 38.35'
Nail & K.C. remon. tag on S side 8" Beech S 70° E 9.15'
Nail & K.C. remon. tag on SW side 24" Pine S 30° E 51.17'
Nail & K.C. remon. tag on NW side 12" Oak S 40° W 47.42'

Nail & K.C. remon. tag on N side 28" Pine S 40° W 4.85'
Nail & K.C. remon. tag on SW side 18" Oak N 60° W 13.58'
Nail & K.C. remon. tag on E side 28" Oak N 10° W 37.33'
Nail & K.C. remon. tag on N side 12" Beech N 40° E 5.44'
Nail & K.C. remon. tag on NE side 24" Oak S 45° E 52.05'

REG. OF DEEDS

STATE OF MICHIGAN
COUNTY OF KENT
RECEIVED FOR RECORD
1999 DEC 27 AM 8:18

11635


Register of Deeds Stamp & File Number

	A	B	C	D	E	F	G	H	I	J	K	L	M
2	6		5		4		3		2		1		
3													
4	7		6		5		4		3		2		1
5													
6	16		15		14		13		12		11		10
7													
8	19		18		17		16		15		14		13
9													
10	30		29		28		27		26		25		24
11													
12	31		30		29		28		27		26		25
13													

P.A. 345 1990 KENT COUNTY

PEER APPROVED 12/2/99

CHAIRMAN Randy Kolehhouse

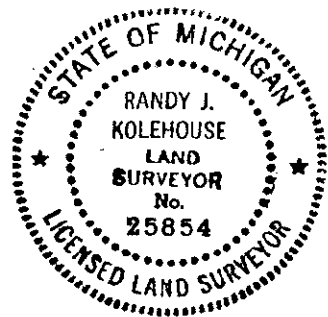

Signed by Randy J. Kolehhouse

Date 12-20-99

WILLIAMS & WORKS

Surveyor's Michigan License No. 25854