

**SURVEY &  
REMONUMENTATION**

**MAR 19 1997**

**COMMISSION**

**LAND CORNER RECORDATION CERTIFICATE**

**Filing Requirement of Act 74, Mich. P.A. 1970**

For corners in

KEWEENAW - REMON

(County)

Located In:

Corner Code #

1. Public Land Survey

T 57N R 32W

H-9

T \_\_\_\_\_ R \_\_\_\_\_

T \_\_\_\_\_ R \_\_\_\_\_

T \_\_\_\_\_ R \_\_\_\_\_

S \_\_\_\_\_ T \_\_\_\_\_ R \_\_\_\_\_

2. Property Controlling  
in Section

S \_\_\_\_\_ T \_\_\_\_\_ R \_\_\_\_\_

3. Miscellaneous

S \_\_\_\_\_ T \_\_\_\_\_ R \_\_\_\_\_

Property in Section

S \_\_\_\_\_ T \_\_\_\_\_ R \_\_\_\_\_

4. Lot No. \_\_\_\_\_, Recorded Plat \_\_\_\_\_

5. Private Claims \_\_\_\_\_

REGISTER'S OFFICE

County of Keweenaw } SS

Received for Record, the 8<sup>th</sup>

day of November A.D. 1996

at 11:00 o'clock A.M., and Recorded

in Liber 1 of LCR

on page 139

Roberta Rosenbarger, Deputy  
Register of Deeds

Register of Deeds Stamp & File Number

I, R. W. CRAMPTON, in a field survey on OCTOBER 30, 19 81,  
do hereby certify that under requirements of P.A. 74, Michigan P.A. of 1970, the corner points mentioned  
in lines 1 and 2 above were in conformance with regulations and rules therefore as required in the current  
manual of survey instructions of the United States Department of the Interior, Bureau of Land  
Management or by a decree of a Court of Law and/or that the corner points mentioned in lines 3, 4 and  
5 above were in conformance with the rules of the Michigan Board of Professional Surveyors or by a  
Decree of a Court of Law; established, re-established, monumented, re-monumented, recovered, found  
as expressed below:

**NOTE: Not more than 4 corners, all in the same town and range, may be recorded  
on this certificate.**

A. Description of original monument and accessories and/or subsequent restoration:


H-9 POST- ACCESSORIES 8" SPRUCE N70W 14, 12" CEDAR S41E 7.

B. Description of corner evidence found and/or method applied in restoring or reestablishing corner:

H-9 2" IRON PIPE IN CONCRETE FOUND, TOP 1.5' BENT EAST, PUNCH HOLE IN BASE OF PIPE.  
IN CENTERLINE OLD UTILITY POLE LINE.

C. Description of monument for corner and accessories established to perpetuate locating the position of the corner:

H-9 THE 2" IRON PIPE WITH 4" BRASS CAP WAS WITNESSED WITH SURVEY TAG NAILED TO:  
4" MAPLE TREE N35W 24.35', 1" TIN SQUARE PLATE NAILED TO TWIN 8" MAPLE TREE N46E 36.43',  
P.K. NAIL IN 6" BALSAM TREE S78E 36.32', P.K. NAIL IN 10' ASPEN TREE S14W 15.67'.

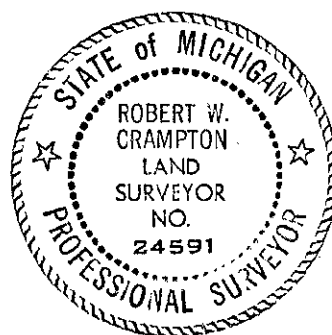

Ratified by Peer Group  
In accordance with P.A. 345  
Co. Rep. Amos M. Hall  
Date 10/15/96

Signed by Robert W. Crampton

Date OCTOBER 1, 1996

Surveyor's Michigan License No. 24591