

# SURVEY & REMONUMENTATION

MAR 19 1997

## COMMISSION

### LAND CORNER RECORDATION CERTIFICATE

Filing Requirement of Act 74, Mich. P.A. 1970

For corners in

Keweenaw  
(County)

Located In:

Corner Code ##

1. Public Land Survey

T 58 R 29

I-1

T 58 R 29

E/F - 3 (3)

2. Property Controlling  
in Section

S T R

3. Miscellaneous  
Property in Sec.

S T R

4. Lot No. , Recorded Plat

5. Private Claims

REGISTER'S OFFICE

County of Keweenaw } SS

Received for Record, the 9th

day of December A.D. 1996

at 1:00 o'clock P.M., and Recorded

in Liber 1 of LCR

on page 151

Robert Rosenberg, Deputy

Register of Deeds

Register of Deeds Stamp & File Number

I, John I. Haataja, in a field survey on August 27, 1996

do hereby certify that under requirements of P.A. 74, Michigan P.A. of 1970, the corner points mentioned in lines 1 and 2 above were in conformance with regulations and rules therefore as required in the current manual of survey instructions of the United States Department of the Interior, Bureau of Land Management or by a decree of a Court of Law and/or that the corner points mentioned in lines 3, 4 and 5 above were in conformance with the rules of the Michigan Board of Land Surveyors or by a Decree of a Court of Law, established, re-established, monumented, re-monumented, recovered, found as expressed below:

NOTE: Not more than 4 corners, all in the same town and range, may be recorded on this certificate.

A. Description of original monument and accessories and/or subsequent restoration:

I-1 N.E. corner Sec. 3

Wood Post

Cedar 10" N 71 E 41 lks.

Cedar 16" N 49 W 46 lks. FND

E/F - 3 Meander cor. between 4 & 9  
Wood Post at high water mark  
Cedar 13" S 50 W 34 lks.  
Fir 14" N 37 W 24 lks.

Description of corner evidence found and/or method applied in restoring or reestablishing corner:

I-1 FND original Cedar BT stump & 4-way Cedar tree.

Re-established cor. from original BT stump (scribes clearly visible)

E/F - 3 No evidence of original corner.  
Re-established at high water mark on line between SW corner, Sec. 4, SE cor. Sec. 3

Ratified by Peer Group  
In accordance with P.A. 345  
Co. Rep. James H. Smith  
Date 12/6/96

Description of monument for corner and accessories established to perpetuate locating the position of the corner:

I-1 N.E. corner Sec. 3


Set 1" pipe with brass cap

7" Maple S 38 E 24.55'

4" Maple N 88 W 11.41'

4" Maple N 19 W 8.85'

12" Cedar N 50 E 2.98'

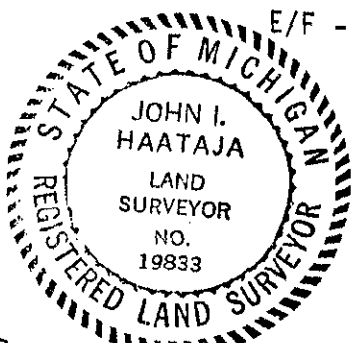

E/F - 3 Meander corner between 4 & 9  
Set 1" pipe with brass cap & sq. cedar post.  
4" Cedar S 15 W 67.55'  
3" Cedar S 26 E 58.35'  
4" Pine N 74 W 85.95'  
4" Tam SNAG N 45 W 60.10'  
25' East to waters edge

ed by John I. Haataja  
Byor's Michigan License No. 19833

Date 11/27/96