

SURVEY &  
REMONUMENTATION

MAR 19 1997 LAND CORNER RECORDATION CERTIFICATE  
Filing Requirement of Act 74, Mich. P.A. 1970  
COMMISSION

For corners in

Keweenaw  
(County)

Located In:

Corner Code ##

1. Public Land Survey

T 58 R 29  
T 58 R 29  
T R  
T R

G/H 3 (1)  
I - 4/5 (5)

2. Property Controlling  
in Section  
3. Miscellaneous  
Property in Sec.

S T R  
S T R  
S T R  
S T R

4. Lot No. , Recorded Plat  
5. Private Claims

REGISTER'S OFFICE }  
County of Keweenaw } SS  
Received for Record, the 9<sup>th</sup>.  
day of December A.D. 1996  
at 1:00 o'clock P.M., and Recorded  
in Liber 1 of LCR  
on page 152  
Robert Rosenburger, Deputy  
Register of Deeds

Register of Deeds Stamp & File Number

I, John I. Haataja, in a field survey on November 14, 19 96  
do hereby certify that under requirements of P.A. 74, Michigan P.A. of 1970, the corner points mentioned  
in lines 1 and 2 above were in conformance with regulations and rules therefore as required in the  
current manual of survey instructions of the United States Department of the Interior, Bureau of Land  
Management or by a decree of a Court of Law and/or that the corner points mentioned in lines 3, 4 and 5  
above were in conformance with the rules of the Michigan Board of Land Surveyors or by a Decree of a  
Court of Law; established, re-established, monumented, re-monumented, recovered, found as  
expressed below:

NOTE: Not more than 4 corners, all in the same town and range, may be recorded  
on this certificate.

A. Description of original monument and accessories and/or subsequent restoration:

G/H - 3 Meander corner between 3 & 10.  
Wood Post at high water mark.  
White Pine 12" S 50 E 37 lks.  
Cedar 10" N 41 E 27 lks.


I - 4/5 Meander corner between 10 & 11.  
Wood Post  
Spruce 9" S 46 E 16 lks.

	A	B	C	D	E	F	G	H	I	J	K	L	M
2	6	5	4	3	2	1							
3													
4	7	8	9	10	11	12							
5													
6	18	17	16	15	14	13							
7													
8	19	20	21	22	23	24							
9													
10	30	29	28	27	26	25							
11													
12	31	32	33	34	35	36							
13													

B. Description of corner evidence found and/or method applied in restoring or reestablishing corner:

G/H - 3 No evidence of original corner  
FND. Re-established on line  
between S.E. cor. Sec. 3 and  
S.W. cor. Sec. 4

I - 4/5 No evidence of original corner  
FND. Re-established during  
survey of Assessor's Plat of  
Lake Medora. This is on line  
between N.E. cor. & S.E. cor.  
of Sec. 9 & on intermediate  
traverse line of the Plat.

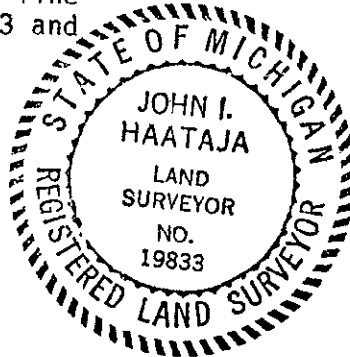

Ratified by Peer Group  
In accordance with P.A. 345  
Co. Rep. James M. Hall  
Date 12/6/96

Description of monument for corner and accessories established to perpetuate locating the position of the corner:

G/H - 3 Meander corner between Sec. 3 & 10.  
Set 1" pipe with brass cap  
6" Cedar N 58 W 9.69'  
16" Cedar N 28 E 7.66'  
4" B. Fir S 51 W 10.93'  
8" Cedar S 69 E 13.85'  
15' West to waters edge

I - 4/5 Meander cor. between 10 & 11.  
Set 1" pipe with brass cap flush  
Lot Pin N 73 W 40.51'  
Conc. Mon. S 73 E 56.73'  
Deck Post/Tag S 16 E 8.60'  
4" B. Fir S 73 W 43.57'  
3' N. to waters edge

ed by John I. Haataja  
eyor's Michigan License No. 19833

Date 11/27/96