

DEC 16 1998

LAND CORNER RECORDATION CERTIFICATE SECTION

Filing Requirement of Act 74, Mich. P.A. 1979

For corners in

Keweenaw (County)

Located In:

Corner Code #

- | | | |
|------------------------------------|---------------------------|-----------------|
| 1. Public Land Survey | T <u>58N</u> R <u>29W</u> | MC10 <u>#10</u> |
| | T. R. | |
| | T. R. | |
| | T. R. | |
| 2. Property Controlling in Section | S. T. R. | |
| | S. T. R. | |
| 3. Miscellaneous Property in Sec. | S. T. R. | |
| | S. T. R. | |

REGISTER'S OFFICE } SS
County of Keweenaw

Received for Record, the 4th
day of December A.D. 1998
at 11:00 o'clock A. M., and Recorded
in Liber 1 of LCR
on page 187
Marilyn Wengert
Register of Deeds Stamp & File Number

4. Lot No. _____, Recorded Plat _____
5. Private Claims _____

I, John I. Haataja, in a field survey on 11/11, 1998,
do hereby certify that under requirements of P.A. 74, Michigan P.A. of 1970, the corner points mentioned
in lines 1 and 2 above were in conformance with regulations and rules therefore as required in the
current manual of survey instructions of the United States Department of the Interior, Bureau of Land
Management or by a decree of a Court of Law and/or that the corner points mentioned in lines 3, 4 and 5
above were in conformance with the rules of the Michigan Board of Land Surveyors or by a Decree of a
Court of Law; established, re-established, monumented, re-monumented, recovered, found as
expressed below:

NOTE: Not more than 4 corners, all in the same town and range, may be recorded on this certificate.

A. Description of original monument and accessories and/or subsequent restoration:

MC-10 Meander corner between Section 31 & 32 T58N-R29W.
Wood post set at high water mark by Samuel Hill in 1847.
Reference: 8" Pitch Pine N20°W 13 lks.
10" Fir N30°W 41 lks.
Concrete monument set for meander corner for Keweenaw County Road plows by John I.
Haataja, P.S. in June 1992.

B. Description of corner evidence found and/or method applied in restoring or reestablishing corner:

MC-10 4" concrete monument with $\frac{1}{2}$ " pin.
6" Spruce N1°E 55.84'
12" Maple S43°E 12.69'
16" Maple S37°W 44.20'
10" Spruce N54°W 60.88'


	A	B	C	D	E	F	G	H	I	J	K	L	M
2	6		5		4		3		2		1		
3													
4	7		8		9		10		11		12		
5													
6	18		17		16		15		14		13		
7													
8	19		20		21		22		23		24		
9													
10	30		29		28		27		26		25		
11													
12	31		32		33		34		35		36		
13													

Ratified by Peer Group
In accordance with P.A. 345
Co. Rep. [Signature]
Date 12/3/98

C. Description of monument for corner and accessories established to perpetuate locating the position of the corner:

MC-10 Established a witness corner 10 feet South of meander corner by placing a 1" pipe with
a 4" brass cap stamped Keweenaw County Remonumentation Point.

14" R. Maple S86°E 9.38'
18" R. Maple S44°W 36.15'
12" Spruce N49°W 67.00'
8" Spruce N01°W 65.85'

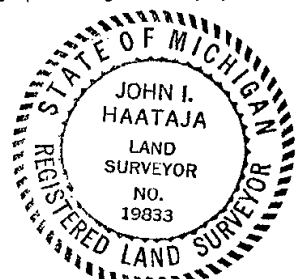

Signed by [Signature]
Surveyor's Michigan License No. 19833

Date 11/11/98