

SURVEY & REMONUMENTATION

AUG 31 1999 LAND CORNER RECORDATION CERTIFICATE FILING REQUIREMENT OF ACT 74, Mich. P.A. 1970

RECORDED LAKE COUNTY, MI.

SECTION

LIBER 004 PAGE 0187  
Jul 23 3 02 PM '99

For corners in Lake

Located in: Corner Code#

1. Public Land Survey T 17N R 11W M-6  
T R  
T R  
T R
2. Property Controlling s T R  
in Section S T R
3. Miscellaneous S T R  
Property in Sec. S T R
4. Lot No. Recorded Plat
5. Private Claims

REGISTER OF DEEDS

Register of Deeds Stamp & File Number

I, Robert L. Wetherell, in a field survey on June 2, 1999, do hereby certify that under requirements of P.A. 74, Michigan P.A. of 1970, the corner points mentioned in lines 1 and 2 above were in conformance with regulations and rules therefore as required in the current manual of survey instructions of the United States Department of the Interior, Bureau of Land Management or by decree of a Court of Law and/or that the corner points mentioned in lines 3, 4, and 5 above were in conformance with the rules of the Michigan Board of Land Surveyors or by a Decree Of a Court of Law; established, re-established, monumented, re-monumented, recovered, found as expressed below:

	A	B	C	D	E	F	G	H	I	J	K	L	M
1													
2	6	5	4	3	2	1							
3	7	8	9	10	11	12							
4													
5	18	17	16	15	14	13							
6													
7	19	20	21	22	23	24							
8													
9	30	29	28	27	26	25							
10													
11	31	32	33	34	35	36							
12													
13													

M-6 - 1/4 Corner Section 13, T17N, R11W

A. Description of original monument and accessories and/or subsequent restoration:

1837 - J. Hodgson, G.L.O.  
10" Sugar for 1/4 Corner

1901 - F. Trumbull, Osc. Co. Sur.  
"Wagon Thimble"  
#1 - Stone 19-1/2 - East

1998 - R.L. Wetherell, LS 24624  
#2 - 15" Maple N35°E 58.42'  
#3 - 8" R. Pine N68°W 46.92'  
#4 - 6" Elm S23°E 63.08'  
#5 - 10" Ash S28°W 64.75'

B. Description of corner evidence found and/or method applied in restoring of reestablishing corner:

I found Trumbull's old wagon thimble 3 feet West of the centerline of North and South road in line with fences East and West.


Condition of the accessories are as follows: #1 Gone, #2 Found in good condition, #3 Found in good condition, #4 Found in good condition, #5 Found in good condition.

C. Description of monument for corner and accessories established to perpetuate locating the position of the corner:

I set a 3/4" re-bar with Lake Co. Remon Cap in the center of the old wagon thimble and is accepted as a careful and faithful re-establishment of the position of the original corner.

15" Maple N35°E 58.42' (60d spike in W. side) #2  
8" Red Pine N68°W 46.92' (60d spike in N. side) #3  
6" Elm S23°E 63.08' (60d spike in W. side) #4  
10" Ash S28°W 64.75' (60d spike in E. side) #5

RATIFIED BY THE LAKE CO. PEER REVIEW GROUP  
IN ACCORDANCE WITH P.A. 345  
CHAIRMAN R.L.W.  
DATE 7-20-99

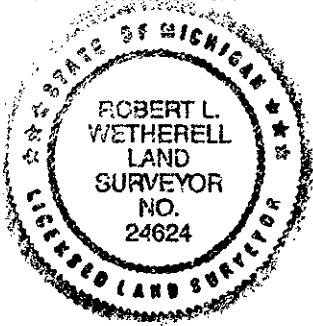

Signed by Robert L. Wetherell

Date July 21, 1999

Surveyor's Michigan License No. 24624