

LAND CORNER RECORDATION CERTIFICATE

Filing Requirement of Act 74, Mich. PA 1970

For Corners In:

Lake

(County)

Located In

Corner Code #



RECEIVED
05/05/2014 3:55:21 PM
LAKE COUNTY, MICHIGAN
SHELLY MYERS, CLERK/REGISTER/CFO

RECORDED
05/05/2014 3:56:18 PM
LAKE COUNTY, MI
SHELLY MYERS, REGISTER OF DEEDS
RECEIPT# 5785, STATION 1
\$14.00 LAND CORNER

1. Public Land Survey T 19N R 11W H2
T _____ R _____
2. Property Controlling in Section S _____ T _____ R _____
S _____ T _____ R _____
3. Miscellaneous Property in Section S _____ T _____ R _____
S _____ T _____ R _____



Liber C8

Page 9

Register of Deeds Stamp & File Number

4. Lot No: _____ Recorded Plat: _____

5. Private Claims: _____

I, Joshua R. Davidson, in a field survey on June 13, 2012 do hereby state that under requirements of PA 74, Michigan PA of 1970, the corner points mentioned in lines 1 and 2 above were in conformance with regulations and rules therefore as required in the current manual of survey instructions of the United States Department of the Interior, Bureau of Land Management or by a decree of a Court of Law and/or that the corner points mentioned in lines 3, 4 and 5 above were in conformance with the rules of the Michigan Board of Land Surveyors or by a Decree of a Court of Law; established, re-established, monumented, recovered, found as expressed below:

NOTE: Not more than 2 corners, all in the same town and range, may be recorded on this certificate.

| | A | B | C | D | E | F | G | H | I | J | K | L | M |
|----|----|---|----|---|---|----|---|----|---|----|---|----|---|
| 1 | | | | | | | | | | | | | |
| 2 | 6 | | 5 | | | 4 | | 3 | | 2 | | 1 | |
| 3 | | | | | | | | | | | | | |
| 4 | 7 | | 8 | | | 9 | | 10 | | 11 | | 12 | |
| 5 | | | | | | | | | | | | | |
| 6 | 18 | | 17 | | | 16 | | 15 | | 14 | | 13 | |
| 7 | | | | | | | | | | | | | |
| 8 | 19 | | 20 | | | 21 | | 22 | | 23 | | 24 | |
| 9 | | | | | | | | | | | | | |
| 10 | 30 | | 29 | | | 28 | | 27 | | 26 | | 25 | |
| 11 | | | | | | | | | | | | | |
| 12 | 31 | | 32 | | | 33 | | 34 | | 35 | | 36 | |
| 13 | | | | | | | | | | | | | |

A. Description of original monument and accessories and/or subsequent restoration:

H2 – Center of section 3, T19N, R11W

1936 – CP Co. field notes, book #311 – Found wood stake 1) Elm 9" N20°E 18.5'; 2) Maple 6" S12°W 20.6'; 3) Maple 8" N30°W 11.3'.

1986 – LCRC L.3, P.15 – C. Roser, PS #12028 – estab. ctr. Of Sec. 3 at intersection of one-quarter lines. Drove 5/8" X 34" re-rod W/r/s cap & ced. Post W/loc tag. – 4) 6" Sugar Maple N10°W 19.4'; 5) 8" Sugar Maple N30°E 10.1'; 6) 11" Sugar Maple S85°W 23.8'; 7) FD CO. PO. CO. iron S21°33'E 56.48'; 8) ELY edge Pine RV Due W 116'.

B. Description of corner evidence found and/or method applied in restoring or re-establishing corner:


H2 – Center of section 3, T19N, R11W

Found 5/8" rebar & cap #12028 per Roser LCRC, 235'± North and 106'± West of Pine River. Also found a 3/4" pipe S20°E 56.48'. Accepted 5/8" rebar & cap #12028 as the best available evidence of the position of the corner and added a stamped 2" DNR aluminum cap.

C. Description of monument for corner and accessories established to perpetuate locating the position of the corner:

H2 – Stamped 2" DNR aluminum cap on 5/8" rebar.

N30°E 10.40' to set nail & tag in SE. side 10" S. Maple (#5)
S20°E 56.48' to found 3/4" pipe (#7)
S83°W 24.12' to set nail & tag in S. side 12" S. Maple (#6)
N08°W 19.75' to set nail & tag in W. side 7" S. Maple (#4)

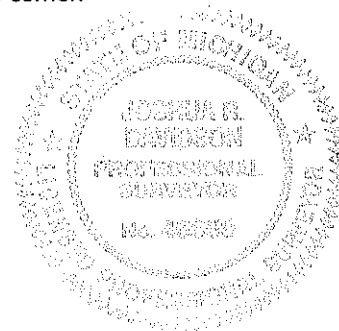

Signed by:

Joshua R. Davidson

Date:

May 5, 2014

Surveyor's Michigan License No.:

46659