


LAND CORNER RECORDATION CERTIFICATE
Filing Requirement of Act 74, Mich. PA 1970

For Corners In: Lake (County) Located In Corner Code #
1. Public Land Survey T R
2. Property Controlling in Section S 9 T 19N R 11W 3
3. Miscellaneous Property in Section S T R
4. Lot No: Recorded Plat:
5. Private Claims:

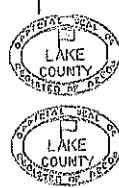

RECEIVED
05/05/2014 3:55:21 PM
LAKE COUNTY, MICHIGAN
SHELLY MYERS, CLERK/REGISTER/CFO

RECORDED
05/05/2014 3:56:18 PM
LAKE COUNTY, MI
SHELLY MYERS, REGISTER OF DEEDS

RECEIPT# 5785, STATION 1
\$14.00 LAND CORNER



Liber 08

Page 8

Register of Deeds Stamp & File Number

I, Joshua R. Davidson, in a field survey on November 21, 2013 do hereby state that under requirements of PA 74, Michigan PA of 1970, the corner points mentioned in lines 1 and 2 above were in conformance with regulations and rules therefore as required in the current manual of survey instructions of the United States Department of the Interior, Bureau of Land Management or by a decree of a Court of Law and/or that the corner points mentioned in lines 3, 4 and 5 above were in conformance with the rules of the Michigan Board of Land Surveyors or by a Decree of a Court of Law; established, re-established, monumented, recovered, found as expressed below:

NOTE: Not more than 2 corners, all in the same town and range, may be recorded on this certificate.

Table with 13 rows and 13 columns (A-M) showing a grid of numbers 1-36. Two dots are marked at the intersection of row 4 and column E, and row 4 and column F.


A. Description of original monument and accessories and/or subsequent restoration:

3 - N 1/16 corner common to sections 8 & 9

4 - NW 1/16 corner section 9

1986 - LCRC - L.3, P.21 - C. Roser, PS #12028 - Estab. 1/8 cor midway & online betw NW COR & W 1/4 of Sec. 9. Set 5/8" X 34" rerod W/RLS cap. - 1) 8" Maple(in clump of 6) N55°W 38.6', 2) 9" W Pine N30°E 82.8', 3) CTR N-S GR RD due E 5', 4) set CED post W/loc tag. Due E 33'.

None

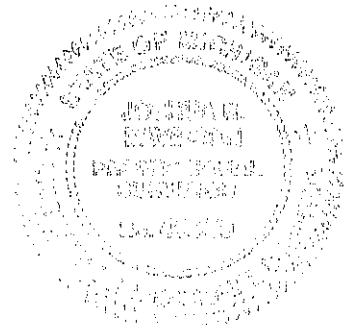

B. Description of corner evidence found and/or method applied in restoring or re-establishing corner:

3 - N 1/16 corner common to sections 8 & 9

4 - NW 1/16 corner section 9

Dug 1.5' below road surface, in search of Roser rebar. No evidence was found. Set a stamped 2" aluminum cap on 5/8" x 34" rebar midway and on line between 'E3' and 'E4'. This position fits Roser witness #1.

Set stamped 2" aluminum cap on 5/8" X 34" rebar per BLM standard procedure. Found Blass T-iron N09°47'W 4.15' from set 2" aluminum cap.

C. Description of monument for corner and accessories established to perpetuate locating the position of the corner:

3 - a stamped 2" Aluminum Cap on 5/8" x 34" rebar

4 - a stamped 2" Aluminum Cap on 5/8" X 34" rebar, set blue post with location tag 1' Northwest

N35°E 63.99' to set nail & tag in NW. side 6" W. Pine
N71°E 61.77' to set nail & tag in S. side 10" W. Pine
S87°35'E 32.93' to found 1/2" rebar & cap #47596
N61°W 39.38' to set nail & tag in NE. side 14" R. Maple in clump of 5. (#1)

N07°E 46.84' to set nail & tag in E. side 9" W. Pine
East 30.49' to set nail & tag in S. side 14" R. Pine
N74°W 46.72' to set nail & tag in N. side 7" W. Pine
N09°47'W 4.15' to found T-Iron

Set blue post with location tag 33' East

Signed by:

Signature of Joshua R. Davidson

Date:

MAY 5, 2014

Surveyor's Michigan License No.:

46659