


LAND CORNER RECORDATION CERTIFICATE
Filing Requirement of Act 74, Mich. PA 1970

Table with 3 columns: Lake (County), Located In, Corner Code #. Rows include Public Land Survey, Property Controlling in Section, and Miscellaneous Property in Section.

4. Lot No: Recorded Plat:
5. Private Claims:

I, Craig W. McVean, in a field survey on June 10, 2013 do hereby state that under requirements of PA 74, Michigan PA of 1970, the corner points mentioned in lines 1 and 2 above were in conformance with regulations and rules therefore as required in the current manual of survey instructions of the United States Department of the Interior, Bureau of Land Management or by a decree of a Court of Law and/or that the corner points mentioned in lines 3, 4 and 5 above were in conformance with the rules of the Michigan Board of Land Surveyors or by a Decree of a Court of Law; established, re-established, monumented, recovered, found as expressed below:

NOTE: Not more than 2 corners, all in the same town and range, may be recorded on this certificate.

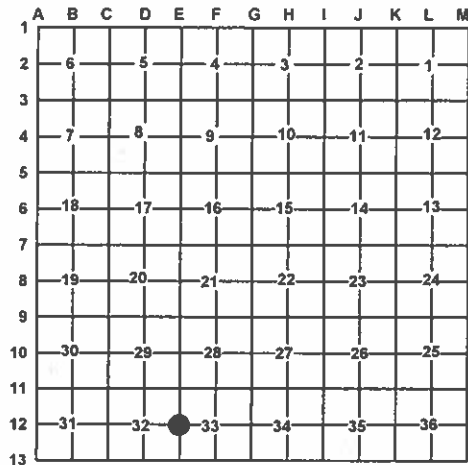

A. Description of original monument and accessories and/or subsequent restoration:

- E12 - 1/4 Corner common to Sections 32 & 33.
- 1838 - GLO - S. Sibley - Set 1/4 post.
1) Tamarack 8" N67°E 23 L.
2) Pine 10" S74°W 15 L.
- 1975 - LCRC L. C002, p. 240 - C. F. Roser (PS #12028)
Set DNR monument and Cedar post - SP
3) 14" White Pine S15°E 58.9'
4) 13" White Pine S10°W 81.0'
5) 20" Red Pine N20°W 73.7'

B. Description of corner evidence found and/or method applied in restoring or re-establishing corner:

E12 - 1/4 Corner common to Sections 32 & 33, T19N, R12W - Found 4" Dept. of Conservation Aluminum cap on 1" iron pipe. No GLO evidence was found. Monument is in cedar swamp about 11' easterly of the swamp edge. Old standing and rotten cedar post is 1'± to southwest. Found stump of witness #5, with witnesses #3 and #4 standing. DNR monument accepted as a careful and faithful reestablishment of the position of the corner.

C. Description of monument for corner and accessories established to perpetuate locating the position of the corner:

- E12 - 1/4 Corner common to Sections 32 & 33.
4" Aluminum Dept. of Conservation cap on 1" galvanized iron pipe
S11°W 81.33' to set nail & tag in W. side 15" White Pine (#4)
S15°E 58.88' to set nail & tag in W. side 18" White Pine (#3)
N58°E 9.26' to set nail & tag in N. side 5" Tamarack
N10°E 46.23' to set nail & tag in W. side 9" Tamarack scribed 'XBT'
N83°W 35.95' to set nail & tag in S. side 7" Cherry
Set Blue Composite post 1' North



Signed by: [Signature]
Surveyor's Michigan License No.: 39088

Date: 8/12/14