

STATE OF MICHIGAN  
DEPARTMENT  
OF  
NATURAL RESOURCES

LAND CORNER RECORD


LAKE COUNTY  
T 19 N R 13 W

DESCRIPTION OF CORNER South 1/4 on South line - Section 35  
CORNER MONUMENT Found 1 1/4" x 18" pipe & set Dept. monument 8" deep in ctr. of E-W sand trail road  
DATE MONUMENT PLACED AND WITNESSED 6-30-72

WITNESSES TO CORNER.....

6" W. Pine	N 30 W	63.5'
10" B. Oak	N 38 E	40.6'
Cedar post w/ location tag	Due S	33'


AND

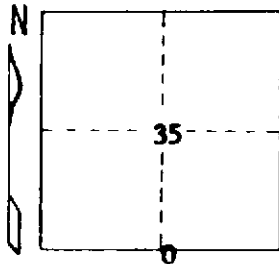

CIRCLE CORNER REGISTERED

DESCRIPTION IN DETAIL AS TO HOW CORNER WAS LOCATED AND IDENTIFIED OR RESTORED.

**Accepted existing recovered corner from previous Blass survey of record.**

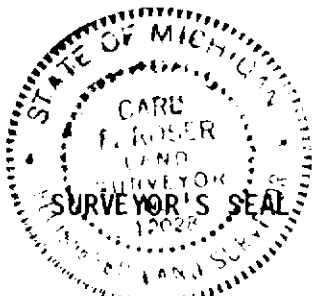

DISTRIBUTION:

Forestry Division, Lansing

SIGNED

*Carl F. Rosser*

DATE

7-7-72

REGISTERED LAND SURVEYOR 12028