

SURVEY &
REMONUMENTATION

MAR 13 1998

SECTION

LAND CORNER RECORDATION CERTIFICATE
Filing Requirement of Act 74, Mich. P.A. 1970
ATTICA TOWNSHIP

RECEIVED FOR RECORD

98 JAN -7 PM 2: 57

For corners in

LAPEER

(County)

Located In:

Corner Code #

1. Public Land Survey

T 7 N R 11 E

M-4

T R

T R

T R

2. Property Controlling
in Section

S

T R

S

T R

3. Miscellaneous
Property in Sec.

S

T R

S

T R

4. Lot No. , Recorded Plat

5. Private Claims

I, WILLIAM E. SODERBERG, in a field survey on May 7, 19 97 do hereby
certify that under requirements of P.A. 74, Michigan P.A. of 1970, the corner points mentioned in lines 1 and 2
above were in conformance with regulations and rules therefore as required in the current manual of survey
instructions of the United States Department of the Interior, Bureau of Land Management or by a decree of a
Court of Law and/or that the corner points mentioned in lines 3, 4 and 5 above were in conformance with the
rules of the Michigan Board of Land Surveyors or by a Decree of a Court of Law; established, re-established,
monumented, re-monumented, recovered, found as expressed below.

NOTE: Not more than 4 corners, all in the same town and range, may be recorded
on this certificate.

A. Description of original monument and accessories and/or subsequent restoration:

GLO 1822	Joseph Wampler	Set post	No witnesses remain
1. Survey 7/28/74	R. Kay #14096	L3, P.702	Unknown
2. LCRC 6/18/90	J. Bailey #33966	L4, P.341	Found 1/2" Iron
3. Survey 6/1/90	J. Bailey #33966	L8, P.874	Found 1/2" Iron

B. Description of corner evidence found and/or method applied in restoring or reestablishing corner:

Found a 1/2" ebar on the centerline of Summers Road (gravel) North and South from witnesses. Existing fence line runs to the West.

Witness found: From items 2 and 3 S. 45° E. 34.96' Nail in 8" Poplar; N.30°E. 47.18' PK nail in 8" Elm; West 44.49' PK nail in 10" Elm; S.45°W. 41.35' Nail in 10" poplar.

Distances: M-4 to M-5 2666.58 feet GLO 40 chs M-4 to A-4 lmlay 59.00 feet
M-3 to M-4 2667.31 feet GLO 40 chs


C. Description of monument for corner and accessories established to perpetuate locating the position of the corner:

We placed a standard Lapeer County Remonumentation Brass cap on found 1/2" rebar stamped #17635 as the best location for this corner as accepted by the Professional Surveyors in this area.

N. 40° E.	46.78'	Set PK/Lapeer County Remon tag in Northwest face 10" Elm
S. 40° E.	35.18	Set pk/Lapeer County Remon tag in Southwest face 10" Poplar
S. 45° W.	41.51'	Set PK/Lapeer County Remon tag in Southeast face 10" Poplar
South	59.00'	Standard Lapeer County Remon Brass disk A-4 lmlay
N. 15° W.	69.42'	Set PK/Lapeer County Remon tag in Southwest face 10" Ash
West	33.00'	Found Iron/cap #33966

Signed by William E. Soderberg Date November 18, 1997

Surveyor's Michigan License No. 17635

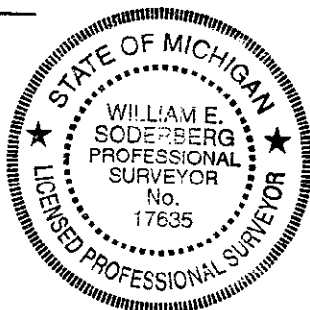

FORM APPROVED BY MICHIGAN STATE BOARD OF LAND SURVEYORS, JAN. 28, 1971
REVISED MAY 14, 1978
REVISED JAN., 1983

LIBER 0006 PAGE 0007