

SURVEY & REMONUMENTATION

MAR 13 1998

SECTION

REMONUMENTATION LAND CORNER RECORDATION CERTIFICATE Filing Requirement of Act 74, Mich. P.A. 1970

RECEIVED FOR RECORD

98 FEB 26 PM 3:20

For corners in
LAPEER

County

Located In:

Corner Code ##

Public Land Survey

T 8N R 10E

A-11

T R

T R

T R

T R

Property Controlling
in Section

S T R

S T R

Miscellaneous

S T R

Property in Sec.

S T R

William DeLong
REGISTER OF DEEDS
LAPEER, MICHIGAN

Register of Deeds Stamp & File Number

Lot No. , Recorded Plat

Private Claims

MICHAEL G. HAY

in a field survey on AUGUST 19 97

do hereby certify that under requirements of P.A. 74, Michigan P.A. of 1970, the corner points mentioned in lines 1 and 2 above were in conformance with regulations and rules therefore as required in the current manual of survey instructions of the United States Department of the Interior, Bureau of Land Management or by a decree of a Court of Law and/or that the corner points mentioned in lines 3, 4 and 5 above were in conformance with the rules of the Michigan Board of Land Surveyors or by a Decree of a Court of Law, established, re-established, monumented, re-monumented, recovered, found as expressed below:

NOTE: Not more than 4 corners, all in the same town and range, may be recorded on this certificate.

Description of original monument and accessories and/or subsequent restoration:

1824 S. Sibley D.S. Set post Sugar 13 S32E 52 Sugar 12 N50E 40

1981 Harold N. Elrich PS # 18986 L 6, P 107 Set p.k. nail S20W 93.87' P. Pole S40W 76.30' 8" Birch S30E 66.37' RR tie post S25E 146.76' Wood post N70W 117.72' P. Pole N45W 52.69' P. Pole N45E 62.55' P. Pole

1981 Harold N. Elrich PS # 18986 L6, P285 Found 1/2" iron Same witnesses.

1981 Leland D. Bates PS # 16699 L6, P311 Found 1/2" iron Same witnesses.

1984 Harold N. Elrich PS # 18986 L6, P710 Found 1/2" iron Same witnesses.

Description of corner evidence found and/or method applied in restoring or reestablishing corner:

1997 Michael G. Hay PS # 41101 Found remonumentation cap in mon box at the intersection of Millville (N-S) and Davis Lake (E-W) Roads. Mon box is located in centerline of Millville Road and and the southerly edge of Davis Lake Road. Remonumentation cap in good shape.

A-11 to L-11 2644.41'


A-11 to A-10 2650.82'

A-11 to B-11 2033.05'

A-11 to A-12 2048.92'

Description of monument for corner and accessories established to perpetuate locating the position of the corner:

A-11 1/2" iron with Remonumentation cap in Monument Box
N70W 116.71" nail and remonumentation tag in power pole
N45E 66.00' nail and remonumentation tag in power pole
S65W 134.43' nail and remonumentation tag in power pole
S25E 108.00' nail and remonumentation tag in power pole

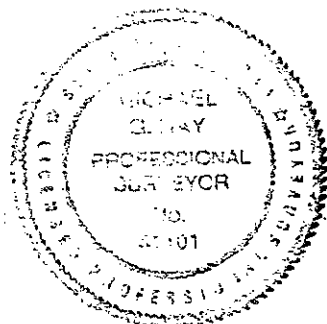

Signed by *Michael G. Hay*

Date September 26, 1997

Surveyor's Michigan License No. 41101

- 1989 Harold N. Elrich PS # 18986 L8, P638 Found 1/2" iron in mon box. S25E 108.00' P.K. nail
in P. Pole N45E 66.00' P.K. nail in light pole N70W 116.71' P.K nail in P. Pole
- 1992 Earl E. Gravlin PS # 23510 L9, P817-818 Found 1/2" iron rod N20E 61.04' 18" cherry
N45E 54.47'E 54.47' 24" oak S85E 30.97' Wood cor. post.
- 1993 Earl E. Gravlin PS # 23510 L10, P142 Found 1/2" iron rod Same witnesses
- 1997 Michael G. Hay PS # 41101 Found Remonumentation cap in mon box