

APR 6 1996

Filing Requirement of Act 74, Mich. P.A. 1970

COMMISSION

For corners in

Lenawee (County)

Located In:

Corner Code #

- 1. Public Land Survey T-8-S R-3-E G-5
2. Property Controlling in Section S-T R
3. Miscellaneous Property in Sec. S-T R

FILED

12:09 P.M.

NOV 21 1995

LENAWEE COUNTY JEANETTE D. KNOX REGISTER OF DEEDS

Register of Deeds Stamp & File Number

- 4. Lot No. Recorded Plat
5. Private Claims

Grid table with columns A-M and rows 1-13. A dot is marked at row 5, column G.

I, Glenn E. Richard, in a field survey on July 14 1995, do hereby certify that under requirements of P.A. 74, Michigan P.A. of 1970, the corner points mentioned in lines 1 and 2 above were in conformance with regulations and rules therefore as required in the current manual of survey instructions of the United States Department of the Interior, Bureau of Land Management or by a decree of a Court of Law and/or that the corner points mentioned in lines 3, 4 and 5 above were in conformance with the rules of the Michigan Board of Land Surveyors or by a Decree of a Court of Law; established, re-established, monumented, re-monumented, recovered, found as expressed below:

NOTE: Not more than 4 corners, all in the same town and range, may be recorded on this certificate.

A. Description of original monument and accessories and/or subsequent restoration:


G.L.O. March 1824 John Mullett set post corner Sections 9, 10, 15 & 16 Elm 18 N 60° E 30 Elm 12 N 62° W 30
Countn't find any records of anyone ever finding or re-establishing this corner

B. Description of corner evidence found and/or method applied in restoring or reestablishing corner:

This corner falls in a 6' to 8' fill area. July 1995, I re-established the corner using the Double Proportionate method between the South 1/4 corners of Sections 9 and 10, Town 8 South, Range 3 East, and the West 1/4 corner of Section 15, Town 8 South, Range 3 East, and the Northeast corner of Section 9, Town 8 South, Range 3 East. Set 5/8" X 2' iron pipe. October 12, 1995, Replaced the iron pipe with 30" Harrison Monument stamped P.S. 13040

C. Description of monument for corner and accessories established to perpetuate locating the position of the corner:

30" Harrison monument stamped P.S. 13040 and is accepted as the best available evidence of the position of the original corner.
dbl. hd. nail & disc. in 14" Ash S 40° E 52.20
dbl. hd. nail & disc. in E.P. S 10° E 102.02
dbl. hd. nail & disc. in 14" Cottonwood S 65° W 23.96
60 d spike at south end of bridge deck in seam North 549.93

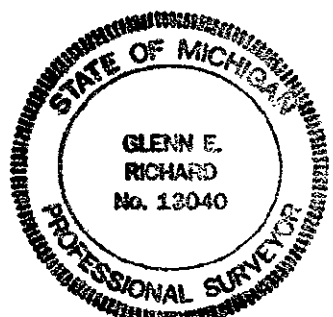

Ratified by Peer Group in accordance with P.A. 345 Co. Rep. Glenn E. Richard Date 9-18-95

Signed by Glenn E. Richard Date Nov. 2, 1995

Surveyor's Michigan License No. 13040