

SURVEY & REMONUMENTATION

OCT 19 1998

SECTION

Filed under Remonumentation Act 345 of 1990
LAND CORNER RECORDATION CERTIFICATE
 Filing Requirement of Act 74, Mich. P.A. 1970

LIBER 1 PAGE 271
 STATE OF MICHIGAN
 LENAWEE COUNTY
 FILED

15 SEP 1998 9:04:33 AM

For corners in

Lenawee
 (County)

Located In:

Corner Code #

VICTORIA J. DANIELS
 REGISTER OF DEEDS

1. Public Land Survey	T-8-S	R-5-E	A-13 ✓
	T-9-S	R-5-E	A-1
	T-8-S	R-4-E	M-13
	T-9-S	R-4-E	M-1
2. Property Controlling in Section	S	T	R
	S	T	R
3. Miscellaneous Property in Sec	S	T	R
	S	T	R

Register of Deeds Stamp & File Number

4. Lot No. _____, Recorded Plat _____
 5. Private Claims _____

	A	B	C	D	E	F	G	H	I	J	K	L	M
1													
2	6	5	4	3	2	1							
3													
4	7	8	9	10	11	12							
5													
6	18	17	16	15	14	13							
7													
8	19	20	21	22	23	24							
9													
10	30	29	28	27	26	25							
11													
12	31	32	33	34	35	36							
13													

I, Glenn E. Richard, in a field survey on July 29, 1998, do hereby certify that under requirements of P.A. 74, Michigan P.A. of 1970, the corner points mentioned in lines 1 and 2 above were in conformance with regulations and rules therefore as required in the current manual of survey instructions of the United States Department of the Interior, Bureau of Land Management or by a decree of a Court of Law and/or that the corner points mentioned in lines 3, 4 and 5 above were in conformance with the rules of the Michigan Board of Land Surveyors or by a Decree of a Court of Law; established, re-established, monumented, re-monumented, recovered, found as expressed below:

NOTE: Not more than 4 corners, all in the same town and range, may be recorded on this certificate.

A. Description of original monument and accessories and/or subsequent restoration:


- 1819 Joseph Fletcher set post cor T's 7&8 S R's 4&5 E Lynn 10 S 81 E 8 Lynn 10 S 85 W 25
- 1875 Burton Kent "The NW corner (Section 1 T9S R5E) was in a wet place and was not found exactly but was set as near as could be ascertained by parole statements of parties who have seen it frequently
- 1884 James Blair set new stake in old stake hole and placed a tile over the same
- 1887 James Blair found stake and tile
- 1889 James Blair found corner stake with iron band over same
- 1890 James Blair found stake, iron & tile
- 1891 James Blair "stake with tile over same"
- 1975 Jack Gillin under my direction re-established the corner. The corner monumentation was lost when a CMP drain culvert was installed through the intersection. Set a 3/4" X 3' iron pipe by retracing Blair's 1889 survey. Extended line south (Blair's record 2603.04') from W 1/4 and NW corner of Section 30. The angle in the SW corner of Section 31 checked Blair's angle 90° 36' I recorded it in L 3 P 346 for A-13 T8S R5E
- 1977 Kenneth Suydam recorded it in L4 P 55 for M-13 T8S R4E

B. Description of corner evidence found and/or method applied in restoring or reestablishing corner:

- July 13, 1998 Found iron pipe in monument box
- July 29, 1998 I replaced the iron pipe with 5/8" X 30" re-rod with a Lenawee County re-mon cap stamped P.S. 13040

C. Description of monument for corner and accessories established to perpetuate locating the position of the corner:

- 5/8" X 30" re-rod with a Lenawee County re-mon cap stamped P.S. 13040 in a monument box and is accepted as the best available evidence of the position of the original corner
- Fd "X" cut on CMP S 55° W 28.76
- Cut "X" on CMP N 40° W 32.57
- Survey mark spike & re-mon tag in E.P. S 70° W 73.20
- NE corner of house foundation S 60° E 120.86

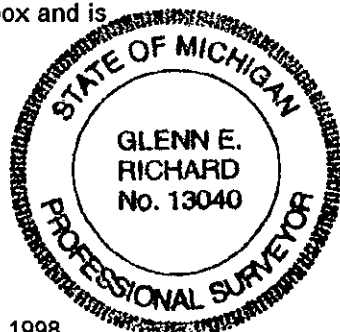

Ratified by Peer Group in accordance with P.A. 345 Co. Rep. Glenn E. Richard Date July 21, 1998

Signed by Glenn E. Richard Date Aug 23, 1998
 Glenn E. Richard

Surveyor's Michigan License No. 13040