

SURVEY & REMONUMENTATION

LUCE COUNTY REMONUMENTATION CORNER

APR 28 1995

LAND CORNER RECORDATION CERTIFICATE

Filing Requirement of Act 74, Mich. P.A. 1970

COMMISSION

For corners in Luce

Located In: _____ Corner Code #/ _____

(County) _____


1. Public Land Survey T 45N R 9W D-3
 T _____ R _____
 T _____ R _____
 T _____ R _____

2. Property Controlling S _____ T _____
 in Section S _____ T _____

3. Miscellaneous S _____ T _____
 Property in Sec. S _____ T _____

4. Lot No. _____, Recorded Plat _____

5. Private Claims _____

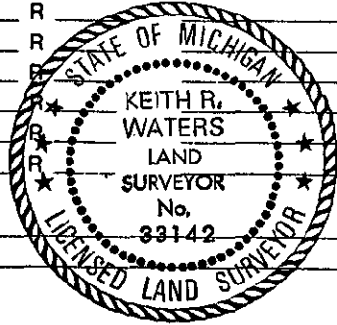

Filed 1/20 A.D., 19 95
 At 12:30 o'clock P.M.
 Liber 2
 File No. page 619
Kathy A. Mahan
 Luce County Reg. of Deeds
 Register of Deeds Stamp & File Number

	A	B	C	D	E	F	G	H	I	J	K	L	M
2	6	5	4	3	2	1							
3													
4	7	8	9	10	11	12							
5													
6	18	17	16	15	14	13							
7													
8	19	20	21	22	23	24							
9													
10	30	29	28	27	26	25							
11													
12	31	32	33	34	35	36							
13													

Keith R. Waters December 7 1994
 I, _____, in a field survey on _____, 19____, do hereby certify that under requirements of P.A. 74, Michigan P.A. of 1970, the corner points mentioned in lines 1 and 2 above were in conformance with regulations and rules therefore as required in the current manual of survey instructions of the United States Department of the Interior, Bureau of Land Management or by a decree of a Court of Law and/or that the corner points mentioned in lines 3, 4 and 5 above were in conformance with the rules of the Michigan Board of Land Surveyors or by a Decree of a Court of Law; established, re-established, monumented, re-monumented, recovered, found as expressed below:

NOTE: Not more than 4 corners, all in the same town and range, may be recorded on this certificate.

A. Description of original monument and accessories and/or subsequent restoration:
D-3 1/4 Corner Common to Sections 5 & 8, T45N, R9W

Original ties to post: Sugar 14, S70°E 40 links Sugar 14, N45°W 13 links.
 Found no evidence of subsequent restoration of this corner.



B. Description of corner evidence found and/or method applied in restoring or reestablishing corner:
D-3 (T45N, R9W)

This corner is being perpetuated as part of the Luce County Remonumentation Program. Found remains of corroded iron pipe on the north edge of an east-west gravel road, on the extension of the centerline of a farm lane to the south. Pipe is 2627.20 feet from section corner to the east, 2668.82 from section corner to the west, and is 2.19 feet north of a straight line between said section corners. Replaced pipe with a 1/2" rebar and cap #33142.

C. Description of monument for corner and accessories established to perpetuate locating the position of the corner:
D-3 (T45N, R9W)
 Corner is a 1/2" rebar with plastic cap #33142 on the north edge of an east-west gravel road, at the centerline of a farm lane to the south. Witnesses:

- 10" Sugar Maple, N23°W 82.13'
- 8" Beech, N10°E 70.80'
- Power Pole (577), NB3°E 108.11'
- 20" Sugar Maple, S17°E 43.50'

Note: Distances are to a nail and tag in the side of the witness object. Trees are blazed and painted. Bearings are compass bearings corrected for declination.

Signed by Keith R. Waters Date 12-23-94
 Surveyor's Michigan License No. 33142