

# SURVEY & REMONUMENTATION

APR 28 1995

## COMMISSION

### LUCE COUNTY REMONUMENTATION CORNER LAND CORNER RECORDATION CERTIFICATE Filing Requirement of Act 74, Mich. P.A. 1970

For corners in

<u>Luce</u> (County)	Located In:	Corner Code #
1. Public Land Survey	T <u>45N</u> R <u>12W</u>	<u>C-10/11</u>
	T _____ R _____	
	T _____ R _____	
	T _____ R _____	
2. Property Controlling in Section	S _____ T _____ R _____	<u>#4</u>
	S _____ T _____ R _____	
3. Miscellaneous Property in Sec.	S _____ T _____ R _____	
	S _____ T _____ R _____	

Filed 1/20 AD., 19 95

At 12:30 o'clock P.M.

Liber 2  
File No. pg. 597

Kathy S. Mahan  
Luce County Reg. of Deeds

Register of Deeds Stamp & File Number

4. Lot No. \_\_\_\_\_, Recorded Plat \_\_\_\_\_  
5. Private Claims \_\_\_\_\_

I, William L. Karr, in a field survey on December 14, 19 94, do hereby certify that under requirements of P.A. 74, Michigan P.A. of 1970, the corner points mentioned in lines 1 and 2 above were in conformance with regulations and rules therefore as required in the current manual of survey instructions of the United States Department of the Interior, Bureau of Land Management or by a decree of a Court of Law and/or that the corner points mentioned in lines 3, 4 and 5 above were in conformance with the rules of the Michigan Board of Land Surveyors or by a Decree of a Court of Law; established, re-established, monumented, re-monumented, recovered, found as expressed below:

NOTE: Not more than 4 corners, all in the same town and range, may be recorded on this certificate.

A. Description of original monument and accessories and/or subsequent restoration:  
(C-10/11) Meander Corner Sections 29 & 30, T.45 N., R.12 W.


1849: G.H. Carleton set meander post 6" Maple N12W 38 lks  
16" Maple N14E 44 lks

1962: F.T. Burgess, P.S. 2531, "Shay's Island View" Sub (Pg. 28 of Plats), shows Meander corner as being set - and relates it to other Plat corners.

B. Description of corner evidence found and/or method applied in restoring or reestablishing corner:

(C-10/11) This corner is being perpetuated as part of the Luce County Remonumentation program.

Found a square concrete monument (same kind as found elsewhere in Plat), at South end of road and 7' North of highwater mark. Distances to other corners in the Plat work well. Accepted corner position as found.

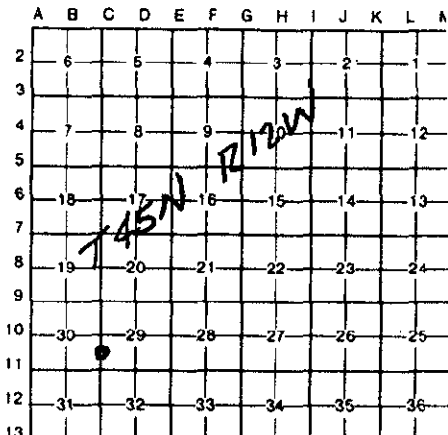


C. Description of monument for corner and accessories established to perpetuate locating the position of the corner:

(C-10/11) Witness Corner to the Meander Corner (W.C.M.C.)

Corner is a square concrete monument at the end of a North-South road and falls 7' North of the high-water mark. Corner falls on the extension of the road centerline to the North.

Witnesses: 4" Cedar in clump	N30°E	43.45'
7" Cedar	N62°E	107.11'
3" Ash	S42°W	26.72'
1-1/2" o.d. witness pipe (set)	N45°W	45.15'

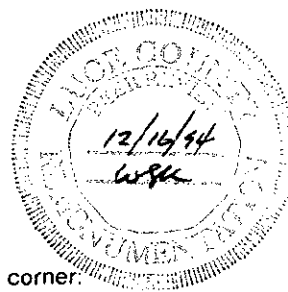

Signed by William L. Karr Date 12/22/94

Surveyor's Michigan License No. 27450

NOTE: Bearings are compass bearings corrected for declination.  
Distances are to a nail in side of witness objects unless noted.