

LAND CORNER RECORDATION CERTIFICATE
Filing Requirement of Act 74, Mich. P.A. 1970 as Amended

For corners in

<u>Luce</u> (County)	Located In:	Corner Code #
1. Public Land Survey	T <u> </u> R <u> </u>	<u> </u>
	T <u> </u> R <u> </u>	<u> </u>
	T <u> </u> R <u> </u>	<u> </u>
	S <u>30</u> T <u>47N</u> R <u>10W</u>	<u>9</u>
2. Property Controlling in Section	S <u>30</u> T <u>47N</u> R <u>10W</u>	<u>6</u>
	S <u> </u> T <u> </u> R <u> </u>	<u> </u>
3. Miscellaneous Property in Sec.	S <u> </u> T <u> </u> R <u> </u>	<u> </u>
	S <u> </u> T <u> </u> R <u> </u>	<u> </u>
4. Lot No. <u> </u> , Recorded Plat <u> </u>		
5. Private Claims		

Register of Deeds Stamp & File
Number

	A	B	C	D	E	F	G	H	I	J	K	L	M
1													
2		6		5		4		3		2		1	
3													
4		7		8		9		10		11		12	
5													
6		18		17		16		15		14		13	
7													
8		19		20		21		22		23		24	
9													
10		30		29		28		27		26		25	
11													
12		31		32		33		34		35		36	
13													

I, Stephan J. Szyszkoski, in a field survey on June 20, 2007 do hereby state that under requirements of P.A. 74, Michigan P.A. of 1970, the corner points mentioned in lines 1 and 2 above were in conformance with regulations and rules therefore as required in the current manual of survey instructions of the United States Department of the Interior, Bureau of Land Management or by a decree of a Court of Law and /or that the corner points mentioned in lines 3, 4 and 5 above were in conformance with the rules of the Michigan Board of Land Surveyors or by a Decree of a Court of Law; established, re-established, monumented, recovered, found as expressed below:

NOTE: Not more than 2 corners, all in the same town and range, may be recorded on this certificate.

A. Description of original monument and accessories and/or subsequent restoration:

(9-Sec. 30) East 1/16 corner, Section 30. Not established in the original survey. Found no subsequent record.

(6-Sec. 30) Northeast 1/16 corner, Sec. 30. Not established in the original survey. Found no subsequent record.

B. Description of corner evidence found and/or method applied in restoring or reestablishing corner:

(9-Sec. 30) Established the corner midway and on a straight line between Quarter corner 1317.93' east and the intersection of 1/4 lines of Sec. 30 1317.93' west.

(6-Sec. 30) Established the corner at the intersection of straight lines connecting opposite 1/16 corners.

C. Description of monument for corner and accessories established to perpetuate locating the position of the corner:

(9-Sec. 30) Set 1"IDx36" I.pipe with 4" alum.

MDNR cap. Set measuring nails in:

24" W.Pine S65W 14.5' mrkd "E1/16 BT"

21" W.Pine S07W 25.93' do

17" Hemlock S29E 20.47' do

11" Tamarack N06W 14.96' do

Bearings are magnetic. Distances are to nail with MDNR tag in side of tree.

(6-Sec. 30) Set 1"IDx36" I.pipe with 4" alum.

MDNR cap. Set nail with MDNR tag in the side of:


5" Cherry S10E 8.1' mrkd "NE1/16 BT"

11" Maple N23W 21.67' do

10" twin Maple S77E 21.42' do

21" W.Pine S14W 23.36' do

Bearings are magnetic. Distances are to nail with tag in the side of tree.

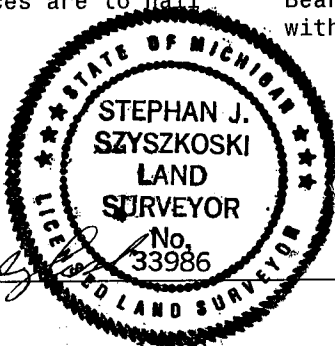

Signed by Stephan J. Szyszkoski Date 12/20/07

Surveyor's Michigan License No. 33986

For the Michigan Department of Natural Resources, Office of Land and Facilities

FORM APPROVED BY MICHIGAN STATE BOARD OF PROFESSIONAL SURVEYORS