

SURVEY &
REMONUMENTATION

MAR 22 1999

CHEBOYGAN COUNTY
REMONUMENTATION CORNER

SECTION

LAND CORNER RECORDATION CERTIFICATE
Filing Requirement of Act 74, Mich. P.A. 1970

For corners in

CHEBOYGAN
(County)

Located In: Corner Code #

1. Public Land Survey T R
T R
T R
T R

2. Property Controlling S 31 T 39N R 2W
in Section S 36 T 39N R 3W 2

3. Miscellaneous S T R
Property in Sec. S T R

RECEIVED FOR RECORD 12-7-98
at 9:06 O'Clock A. M

Joanne Spray

CLERK/REGISTER
CHEBOYGAN COUNTY, MICHIGAN

Register of Deeds Stamp & File Number

4. Lot No. , Recorded Plat
5. Private Claims

I, JAMES H. GRANGER, in a field survey on July 15, 1998 do hereby state that under requirements of P.A. 74, Michigan P.A. of 1970, the corner points mentioned in lines 1 and 2 above were in conformance with regulations and rules therefore as required in the current manual of survey instructions of the United States Department of the Interior, Bureau of Land Management or by a decree of a Court of Law and /or that the corner points mentioned in lines 3, 4 and 5 above were in conformance with the rules of the Michigan Board of Land Surveyors or by a Decree of a Court of Law; established, re-established, monumented, recovered, found as expressed below:

NOTE: Not more than 2 corners, all in the same town and range, may be recorded on this certificate.

A. Description of original monument and accessories and/or subsequent restoration:


1840 Original survey Set Wood Post 8" Cedar S33°E 51 lks
Harvey Mellen 8" Spruce S71°W 63 lks

1930 Survey Gregory Shadko, PE Set Concrete Monument
Gregory Shadko, P.E.

1973 Survey Fd. Concrete Monument
George Young #10710

1992 Survey Fd. Concrete Monument
James H. Granger #16041

	A	B	C	D	E	F	G	H	I	J	K	L	M
1													
2	6		5		4		3		2		1		
3													
4	7		8		9		10		11		12		
5													
6	18		17		16		15		14		13		
7													
8	19		20		21		22		23		24		
9													
10	30		29		28		27		26		25		
11													
12	31		32		33		34		35		36		
13													

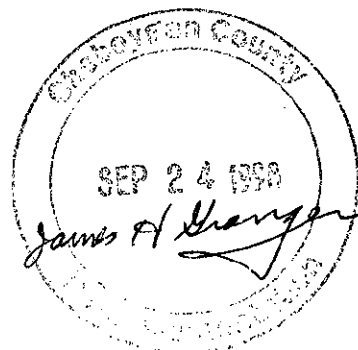

B. Description of corner evidence found and/or method applied in restoring or reestablishing corner:

Fd. concrete monument per unrecorded Plat of Island View Shores with top broken off. Dug down to straight portion to establish position. Existing Monument is witness corner to GLO Meander Corner.

C. Description of monument for corner and accessories established to perpetuate locating the position of the corner:

5/8" rebar and remonumentation cap in concrete monument


6" Cedar N50°W 42.28' set tag #16041

6" Cedar S38°W 24.02' set tag #16041

14" Pine S19°W 91.98' set tag #16041

8" Spruce S38°E 150.40' set tag #16041

Original Meander Corner 166.04 ft on Township line extension

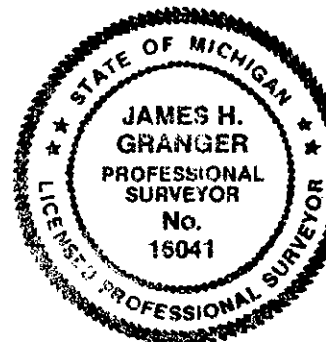

Signed by James H. Granger
Surveyor's Michigan License No. 16041

Date November 2, 1998