

SURVEY & REMONUMENTATION
MACKINAC COUNTY REMONUMENTATION CORNER
LAND CORNER RECORDATION CERTIFICATE
Filing Requirement of Act 74, Mich. P.A. 1970

For corners

Mackinac

(County)

Located In:

Corner Code ##

1. Public Land Survey T R
T R
T R
T R
2. Property Controlling S 15 T 40N R 4W
in Section S T R
3. Miscellaneous S T R
Property in Sec. S T R

#5

H-5

RECEIVED & FILED
DIANE FRANKOVICH
MACKINAC COUNTY CLERK OF DEEDS

NOV 09 1994
AM 7:18 PM 1:16
10/11/12/13/14/15/16

Register of Deeds Stamp & File Number

4. Lot No. , Recorded Plat
5. Private Claims

I, Neil E. Hill, in a field survey on October 3, 19 94,
do hereby certify that under requirements of P.A. 74, Michigan P.A. of 1970, the corner points mentioned
in lines 1 and 2 above were in conformance with regulations and rules therefore as required in the
current manual of survey instructions of the United States Department of the Interior, Bureau of Land
Management or by a decree of a Court of Law and/or that the corner points mentioned in lines 3, 4 and 5
above were in conformance with the rules of the Michigan Board of Land Surveyors or by a Decree of a
Court of Law; established, re-established, monumented, re-monumented, recovered, found as
expressed below:

**NOTE: Not more than 4 corners, all in the same town and range, may be recorded
on this certificate.**

A. Description of original monument and accessories and/or subsequent restoration:

Set 4" cedar post at 40 ch.

No witnesses

GLO notes differ from the GLO map.

Charlevoix Engineering & Abstract has done some work in Section 15 over the past years and has
discovered an error in the GLO map. T.L. Jackson used this error to survey in Section 10.

B. Description of corner evidence found and/or method applied in restoring or reestablishing corner:

No record of this corner.

See back for corner locations along Section Line.

C. Description of monument for corner and accessories established to perpetuate locating the position of the corner:

Found no corner. Set 5/8" re-rod with 4" aluminum cap.

8" Birch S65E 10.92'

8" Birch N70W 14.10'

14" Birch N30E 11.93'

10" Cedar N85E 06.78'

ACCEPTED BY THE MACKINAC COUNTY
SURVEY PEER GROUP AS THE
OFFICIAL CORNER UNDER P.A.
345 OF 1990 AT A MEETING
HELD ON 10-17-94

James H. Krueger



Signed by Neil E. Hill P.S. Date October 17, 1994

Surveyor's Michigan License No. 27447

**SURVEY &
REMONUMENTATION
APR 10 1995
COMMISSION**

Moran Township, Mackinac County, Michigan

Section 10 T40N, R4W

GLO Notes 3579.18' 3522.84'

Witnesses #15 Sec. 10

- 6" I. Pine N75E 67.05'
- 4" I. Pine S70E 14.10'
- 5" Cedar N25E 13.22'
- 8" Cedar S75W 22.45'

SW 1/4 of SW 1/4

#15 Sec. 10
Set 1/2" re-rod
w/ cap #27447

Gout. Lot #2

5/16 Cor. Sec. 10
Set std. FF5 mon.

SE 1/4 of SE 1/4

1299.22'

1524.03'

Gout. Lot #8

#1 Sec. 15

Set 1/2" re-rod w/ cap #27447

- 20" Norway Pine N80W 17.30'
- 9" Cedar N50W 41.36'
- 10" Cedar S35E 20.45'
- 5" Cedar N85E 47.04'

NE 1/4 of NW 1/4

Property Controlling Gout. Lot #1

N 1/4 Cor. Sec. 15


Set sta. County Monu.
5/16" re-rod w/ 4" minimum cap

1299.22'

1324.94'

924.40'

673.87'

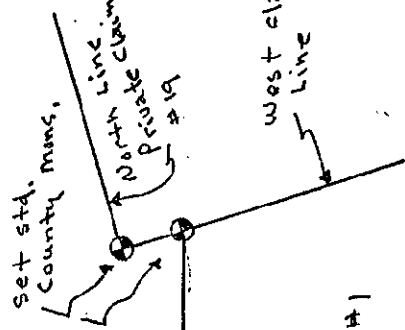

Section 15 T40N, R4W

GLO map 3313.20'

indicates Gout. Lot #1
North Line 673.20' GLO