
MACKINAC COUNTY REMONUMENTATION CORNER

LAND CORNER RECORDATION CERTIFICATE

For corners in	Filing Require	ement of Act 74, Mich. P.A. 1	970
Mackinac (County)	Located In:	Corner Code ##	RECEIVED & FILED
Public Land Survey .	т <u>40 N</u> R <u>04W</u> Т В	P.C.C. 14 NW Cor. PC 14	DEC 1 1 1995
 Property Controlling in Section Miscellaneous Property in Sec. 	T R T R S T R S T R S T R	#19	AM PM 7[8[5]
4. Lot No ,	Recorded Plat		
			A B C D E F G H I J K L
			3
Neil E. Hill	, in a field survey on NOVE	MBER 17 19 95	4 7 8 9 10 11 1 1 5 5 5 5 6 6 6 6 6 6 6 6 6 6 6 6
in lines 1 and 2 above were in current manual of survey instr Management or by a decree of above were in conformance w Court of Law; established, expressed below:	equirements of P.A. 74, Michigan P.A. in conformance with regulations an ructions of the United States Depart fa Court of Lawand/or that the corne with the rules of the Michigan Board or re-established, monumented, re-n	d rules therefore as required in the ment of the Interior, Bureau of Land r points mentioned in lines 3, 4 and 5 f Land Surveyors or by a Decree of a nonumented, recovered, found as	8 19 20 21 22 23 2
on this certificate).		12 31 32 33 34 35 3
A. Description of original	monument and accessories and	/or subsequent restoration:	13
GLO notes. Set post 8" Cedar N5 7" Tamarack N1	60E 19 lks. 8W 4 lks		
See sketch on reverse			
		ST Claim Line. ACCEPTED BY THE MACKINAC OSURVEY PECH OF UP AS THE OFFICIAL COMPETI UNDER P.A. 345 OF 1990 AT A MEETING	OF MICHONINA NEIL E.
		HELDON 9-18-98	Me Marine Marine
C. Description of monume	ent for corner and accessories e	stablished to perpetuate location	g the position of the corner:
3" Baisam N 18" Cedar Si 12" Tw. Cedar Sc	15W 11.78' N	51-03-40E 470.50 feet t	nentation comer. o intersection N-S Section Line o NW Cor. PC 15

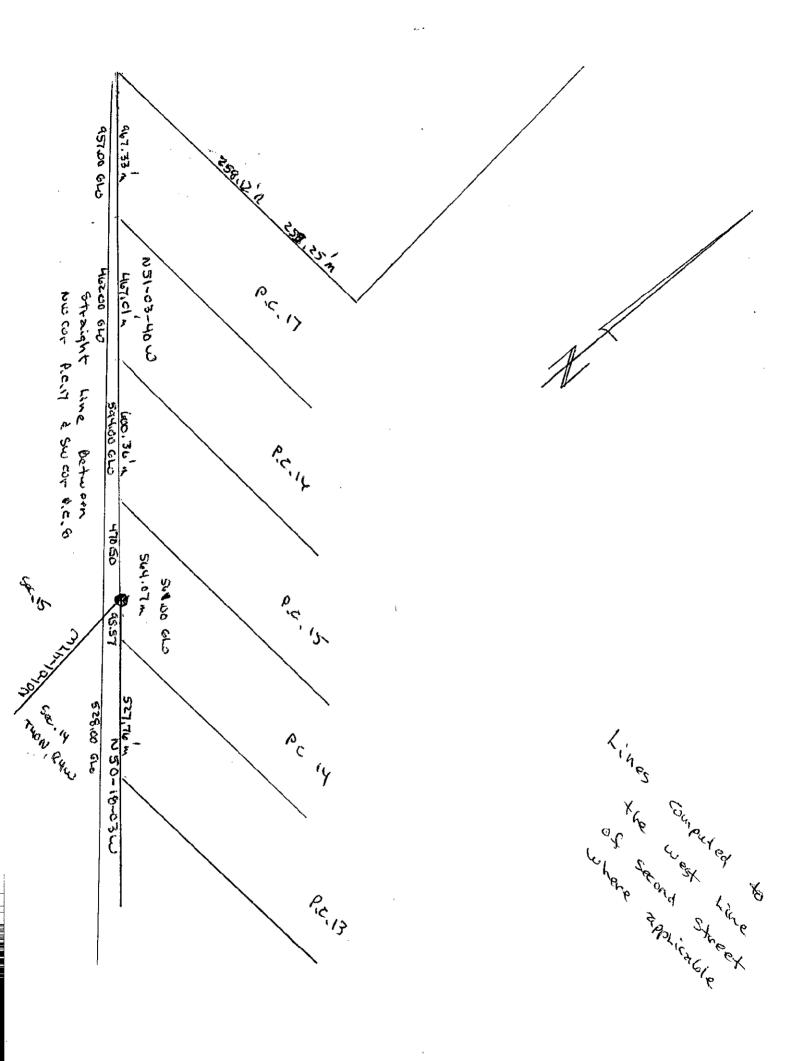

Not to Scale