

MICHIGAN
DEPARTMENT OF CONSERVATION
FORESTRY DIVISION

LAND CORNER RECORD

T. 42 NR. 1 W.

Mackinac COUNTY

DESCRIPTION OF CORNER S. W. 1/8 corner of Section 17

DESCRIPTION OF CORNER MONUMENT 1 1/2" iron pipe


WITNESSES TO CORNER 18" Cedar N 59° W 38 links

Marked "BT"

18" W. Pine S 42° W 36 links

Marked "BT"

N.

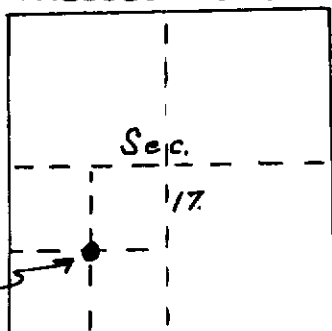

DESCRIPTION IN DETAIL AS TO HOW CORNER WAS LOCATED AND IDENTIFIED OR RESTORED.

1/8
S.W. 1/8 Corner placed at intersection of lines quartering the SW 1/4 of Section.

SURVEYORS SEAL

SIGNED Billy D. Buckles DATE 5/2/57
REGISTERED LAND SURVEYOR