

MICHIGAN  
DEPARTMENT OF CONSERVATION  
FORESTRY DIVISION

# LAND CORNER RECORD

T. 42N N.R. 18


Mackinac COUNTY

DESCRIPTION OF CORNER Sec. Cor. common to 14-15-22-23

CORNER MONUMENT 1" pipe with 4" aluminum cap.

DATE MONUMENT PLACED AND WITNESSED 5-18-70

WITNESSES TO CORNER..... 9" Cedar (S23 NBT) S21°E 25.7'

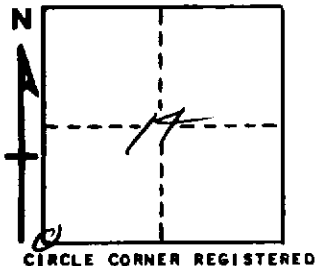

10" Cedar (S14 NBT) N78°E 29.5'

12" Cedar (S15 NBT) N46°W 32.9'

AND  
11" Cedar (S22 NBT) S48°W 22.6'

DESCRIPTION IN DETAIL AS TO HOW CORNER WAS LOCATED AND IDENTIFIED OR RESTORED.

This corner re-established from an original corner, one mile north;  $\frac{1}{4}$  corner,  $1\frac{1}{2}$  miles south; county road, one mile west and county road, one mile east.

Found no evidence of original corner.

Squared and scribed a 9" W. Spruce, 2.0' northeast of the corner.

SURVEYOR'S SEAL

SIGNED Billy D. Buckler DATE 8-4-70  
REGISTERED LAND SURVEYOR