

SURVEY &
REMONUMENTATION

MAR 13 1998

1997 Mackinac County Remonumentation Corner
LAND CORNER RECORDATION CERTIFICATE
Filing Requirement of Act 74, Mich. P.A. 1970

SECTION

For corners in

	<u>Mackinac</u> (County)	Located In:	Corner Code #
1. Public Land Survey		T <u>42NR 1W</u>	<u>G-5</u>
		T <u> </u> R <u> </u>	<u> </u>
		T <u> </u> R <u> </u>	<u> </u>
		T <u> </u> R <u> </u>	<u> </u>
2. Property Controlling in Section	S <u> </u>	T <u> </u> R <u> </u>	<u> </u>
	S <u> </u>	T <u> </u> R <u> </u>	<u> </u>
3. Miscellaneous Property in Sec.	S <u> </u>	T <u> </u> R <u> </u>	<u> </u>
	S <u> </u>	T <u> </u> R <u> </u>	<u> </u>

RECEIVED & FILED
DIANE FRANKOVICH
MACKINAC COUNTY REGISTER OF DEEDS

DEC 18 1997
AM PM
7/8/9/10/11/12/13/14/15/16

Register of Deeds Stamp & File Number

4. Lot No. , Recorded Plat
5. Private Claims

I, David B. Guthrie, in a field survey on July 8, 19 97 do hereby state that under requirements of P.A. 74, Michigan P.A. of 1970, the corner points mentioned in lines 1 and 2 above were in conformance with regulations and rules therefore as required in the current manual of survey instructions of the United States Department of the Interior, Bureau of Land Management or by a decree of a Court of Law and/or that the corner points mentioned in lines 3, 4 and 5 above were in conformance with the rules of the Michigan Board of Land Surveyors or by a Decree of a Court of Law; established, re-established, monumented, recovered, found as expressed below:

NOTE: Not more than 2 corners, all in the same town and range, may be recorded on this certificate.

	A	B	C	D	E	F	G	H	I	J	K	L	M
1													
2	6		5		4		3		2		1		
3													
4	7		8		9		10		11		12		
5													
6	18		17		16		15		14		13		
7													
8	19		20		21		22		23		24		
9													
10	30		29		28		27		26		25		
11													
12	31		32		33		34		35		36		
13													

A. Description of original monument and accessories and/or subsequent restoration:

1845: G.L.O. Survey by J.H. Mullett - Set Post and Referenced -
Beech 10 / S43W / 15
W. Pine 20 / N18E / 34

1988: Survey by Ronald Bischer - Found 1/2" Iron buried in Road.
Referenced -
N84°E - 8" Oak - 34.80'
S78°W - P.Pole - 26.18'
S55°E - 7" Maple - 73.29'

B. Description of corner evidence found and/or method applied in restoring or reestablishing corner:


1997: Remonumentation Survey by R.S. Scott Associates, Inc.
Fd. 3/8" Iron Rod 1.5' W. of Road C.L.
Referenced -
(Exist.) S80°W - Utility Pole - 26.13'
N38°W - 12" Red Pine - 53.76'
N45°E - 12" Oak - 54.90'
N87°E - 18" Oak - 35.03'

ACCEPTED BY THE MACKINAC COUNTY
SURVEY PEER GROUP AS THE
OFFICIAL CORNER UNDER P.A.
345 OF 1990 AT A MEETING
HELD ON 11-21-97

This corner position is compatible with County and local surveys. This corner position is accepted as a careful and faithful perpetuation of the position of the original corner.

C. Description of monument for corner and accessories established to perpetuate locating the position of the corner:

1997: Placed 3" Mackinac County Cap stamped to identify corner over 1/2" Iron Rod in Monument Box.
Referenced -
(Exist.) S80°W - Utility Pole - 26.13'
N38°W - 12" Red Pine - 53.76'
N45°E - 12" Oak - 54.90'
N87°E - 18" Oak - 35.03'

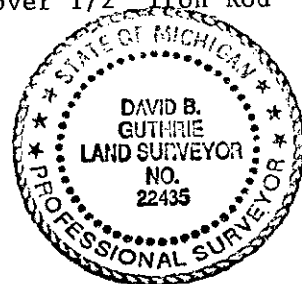

Signed by David B. Guthrie
Surveyor's Michigan License No. 22435

Date 12-12-97

SURVEY &
REMONUMENTATION

MAR 13 1998

SECTION

(CONT'D FROM OTHER SIDE)

A.

1995: Survey by Ronald Bischer - 1/2" Iron Rod

Referenced -

S69°W - 16" Ash - 57.29'

N54°W - 5" Maple - 47.95'

S88°W - 1/2" Iron Rod - 33.00'

S76°E - Utility Pole - 64.25'