

SURVEY & REMONUMENTATION

MAR 13 1998

SECTION

1997 Mackinac County Remonumentation Corner LAND CORNER RECORDATION CERTIFICATE Filing Requirement of Act 74, Mich. P.A. 1970

For corners in

<u>Mackinac</u>	Located In:	Corner Code #
(County)		
1. Public Land Survey	T42N R1W	G-9
	T___ R___	_____
	T___ R___	_____
	T___ R___	_____
2. Property Controlling in Section	S___ T___ R___	_____
	S___ T___ R___	_____
3. Miscellaneous Property in Sec.	S___ T___ R___	_____
	S___ T___ R___	_____

RECEIVED & FILED
DIANE FRANKOVICH
MACKINAC COUNTY REGISTER OF DEEDS

DEC 18 1997

AM PM
7/8/9/10/11/12/13/14/15/16

Register of Deeds Stamp & File Number

4. Lot No. _____, Recorded Plat _____
5. Private Claims _____

I, David B. Guthrie, in a field survey on July 2, 1997 do hereby state that under requirements of P.A. 74, Michigan P.A. of 1970, the corner points mentioned in lines 1 and 2 above were in conformance with regulations and rules therefore as required in the current manual of survey instructions of the United States Department of the Interior, Bureau of Land Management or by a decree of a Court of Law and/or that the corner points mentioned in lines 3, 4 and 5 above were in conformance with the rules of the Michigan Board of Land Surveyors or by a Decree of a Court of Law; established, re-established, monumented, recovered, found as expressed below:

NOTE: Not more than 2 corners, all in the same town and range, may be recorded on this certificate.

	A	B	C	D	E	F	G	H	I	J	K	L	M
1													
2	6		5		4		3		2		1		
3													
4	7		8		9		10		11		12		
5													
6	18		17		16		15		14		13		
7													
8	19		20		21		22		23		24		
9													
10	30		29		28		27		26		25		
11													
12	31		32		33		34		35		36		
13													

A. Description of original monument and accessories and/or subsequent restoration:

1845: G.L.O. Survey by J.H. Mullett - Set Post and Referenced -
Fir 10 / N34E / 30
Cedar 10 / S52W / 27

1977: Survey by Lawrence R. Fientdt - Fd. T-Iron in Mon. Box in C.L. of intersection of
3 Mile and Nye Roads.

Referenced -
N40°W - Pwr. Pole - 58.90'
S55°W - Pwr. Pole - 77.60'
S35°E - Pwr. Pole - 71.40'

(CONT'D ON OTHER SIDE)

B. Description of corner evidence found and/or method applied in restoring or reestablishing corner:

1997: Remonumentation Survey by R.S. Scott Associates, Inc.
Fd. T-Iron in Monument Box.

Referenced -
(Exist.) N52°E - 15" Spruce - 60.41'
(Exist.) S45°W - 15" Spruce - 62.15'
(Exist.) S25°E - Utility Pole - 69.30'
(Exist.) N25°W - Utility Pole - 59.80'


This corner position is compatible with County and local surveys. This corner position is accepted as a careful and faithful perpetuation of the position of the original corner.

C. Description of monument for corner and accessories established to perpetuate locating the position of the corner:

1997: Placed 3" Mackinac County Cap stamped to identify the corner over 1/2" Iron Rod, in Monument Box.

Referenced -
(Exist.) N52°E - 15" Spruce - 60.41'
(Exist.) S45°W - 15" Spruce - 62.15'
(Exist.) S25°E - Utility Pole - 69.30'
(Exist.) N25°W - Utility Pole - 59.80'

ACCEPTED BY THE MACKINAC COUNTY
SURVEY PEER GROUP AS THE
OFFICIAL CORNER UNDER P.A.
345 OF 1990 AT A MEETING
HELD ON 11-21-97

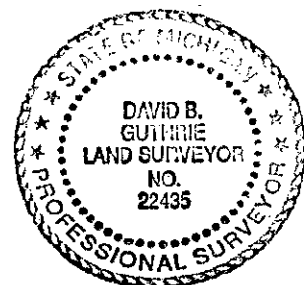

Signed by David B. Guthrie
Surveyor's Michigan License No. 22435

Date 12-12-97