

SURVEY &
REMONUMENTATION

MAR 13 1998

SECTION

1997 Mackinac County Remonumentation Corner
LAND CORNER RECORDATION CERTIFICATE
Filing Requirement of Act 74, Mich. P.A. 1970

For corners in

Mackinac Located In: Corner Code #
(County)

1. Public Land Survey T 42NR 1W M-4
T 42NR 1E A-4
T R
T R
2. Property Controlling S T R
in Section S T R
3. Miscellaneous S T R
Property in Sec. S T R

RECEIVED & FILED
DIANE FRANKOVICH
MACKINAC COUNTY CLERK OF DEEDS

DEC 31 1997
AM PM
7|8|9|10|11|12|1|2|3|4|5|6

Register of Deeds Stamp & File Number

4. Lot No. , Recorded Plat
5. Private Claims

I, David B. Guthrie, in a field survey on Dec. 17, 1997 do hereby state that under requirements of P.A. 74, Michigan P.A. of 1970, the corner points mentioned in lines 1 and 2 above were in conformance with regulations and rules therefore as required in the current manual of survey instructions of the United States Department of the Interior, Bureau of Land Management or by a decree of a Court of Law and/or that the corner points mentioned in lines 3, 4 and 5 above were in conformance with the rules of the Michigan Board of Land Surveyors or by a Decree of a Court of Law; established, re-established, monumented, recovered, found as expressed below:

NOTE: Not more than 2 corners, all in the same town and range, may be recorded on this certificate.

	A	B	C	D	E	F	G	H	I	J	K	L	M
1													
2		6		5		4		3		2		1	
3													
4		7		8		9		10		11		12	
5													
6		18		17		16		15		14		13	
7													
8		19		20		21		22		23		24	
9													
10		30		29		28		27		26		25	
11													
12		31		32		33		34		35		36	
13													

A. Description of original monument and accessories and/or subsequent restoration:

1840: G.L.O. Survey by Wm. A. Burt - Set Post and Referenced -
Cedar 10 / S8W / 12
Tamarack 12 / N66W / 9

1992: Survey by Neil Hill - Found 1/2" Copper clad rod in Ely side of Monument Box.
Liber D Page 137

B. Description of corner evidence found and/or method applied in restoring or reestablishing corner:

1997: Remonumentation survey by R.S. Scott Associates, Inc.
Found 1/2" rod in Monument Box.

This corner position is compatible with County and local surveys. This corner position accepted as a careful and faithful perpetuation of the position of the original corner.


ACCEPTED BY THE MACKINAC COUNTY
SURVEY PEER GROUP AS THE
OFFICIAL CORNER UNDER P.A.
345 OF 1990 AT A MEETING
HELD ON 12-19-97

C. Description of monument for corner and accessories established to perpetuate locating the position of the corner:

1997: Placed a 3" Mackinac County Cap stamped to identify the corner over 1/2" Iron Rod in Monument Box.

Referenced -

(Exist.) Tag#22428 - S60°W - 90.45' - 14" Spruce
(Exist.) MDOT Tag - S85°W - 77.62' - 12" Poplar
(Exist.) MDOT Tag - N70°W - 76.34' - 10" Poplar
(Exist.) Tag#22428 - S45°E - 80.21' - P.P.

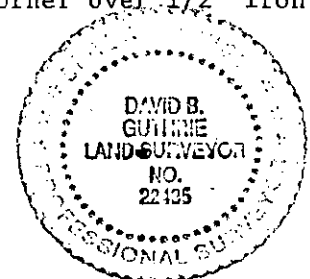

Signed by David B. Guthrie
Surveyor's Michigan License No. 22435

Date 12-22-97