

LAND CORNER RECORDATION CERTIFICATE  
Filing Requirement of Act 74, Mich. P.A. 1970

For corners in  
Mackinac

(County)

Located in:

Corner Code #

1. Public Land Survey	T	R	
	T	R	
	T	R	
	T	R	
2. Property Controlling in Section	S 16	T 42N	R 1W
	S 16	T 42N	R 1W
3. Miscellaneous Property in Sec.	S	T	R
	S	T	R

4. Lot No. \_\_\_\_\_, Recorded Plat \_\_\_\_\_  
5. Private Claims \_\_\_\_\_

6 Sep 23 2002  
8 Sep 24 2002

I, Stephan J. Szyszkoski, in a field survey on \_\_\_\_\_, 19\_\_\_\_ do hereby state that under requirements of P.A. 74, Michigan P.A. of 1970, the corner points mentioned in lines 1 and 2 above were in conformance with regulations and rules therefore as required in the current manual of survey instructions of the United States Department of the Interior, Bureau of Land Management or by a decree of a Court of Law and/or that the corner points mentioned in lines 3, 4 and 5 above were in conformance with the rules of the Michigan Board of Land Surveyors or by a Decree of a Court of Law, established, re-established, monumented, recovered, found as expressed below:

NOTE: Not more than 2 corners, all in the same town and range, may be recorded on this certificate.

	A	B	C	D	E	F	G	H	I	J	K	L	M
1													
2	6	5	4	3	2	1							
3													
4	7	8	9	10	11	12							
5													
6	18	17	16	15	14	13							
7													
8	19	20	21	22	23	24							
9													
10	30	29	28	27	26	25							
11													
12	31	32	33	34	35	36							
13													


A. Description of original monument and accessories and/or subsequent restoration:  
(8-Sec. 16) West 1/16 corner. Not established in the original survey. Found no subsequent record.  
(6-Sec. 16) Northeast 1/16 corner. Not established in the original survey. Found no subsequent record.

B. Description of corner evidence found and/or method applied in restoring or reestablishing corner:

(8-Sec. 16) Established the corner midway and on a straight line between Quarter corner 1320.55' west and Center of Section 1320.55' east.  
(6-Sec. 16) Established the corner at the intersection of straight lines connecting opposite 1/16 corners.

C. Description of monument for corner and accessories established to perpetuate locating the position of the corner:

(8) Set 1"10x36" I.pipe with 4" dia. alum. MDMR cap. Blazed, scribed, and set measuring nails in:	(6) Set 1"10x36" I.pipe with 4" dia. alum. MDMR cap. Blazed, scribed, and set measuring nails in:
6" Maple N32W 17.35'	"W1/16 8T"
8" Maple N09E 12.8'	do
6" twin Maple N88E 3.95'	do
8" Maple S36W 11.25'	do
Center of road is 22' north. Set cedar post adjacent. Bearings are magnetic. Distances are to nail with tag.	Iron fence post N45W 1.1'

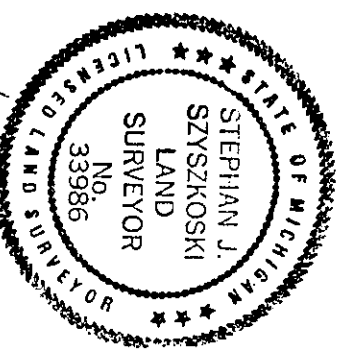

Signed by Stephan J. Szyszkoski  
Surveyor's Michigan License No. 33986

Date 12/3/02

Register of Deeds Stamp & File Number