

LAND CORNER RECORDATION CERTIFICATE  
Filing Requirement of Act 74, Mich. P.A. 1970

For corners in

Mackinac

(County)

Located In:

Corner Code #

1. Public Land Survey

T\_\_ R\_\_  
T\_\_ R\_\_  
T\_\_ R\_\_

2. Property Controlling

S 16 T 42N R 1W

3. Miscellaneous

S\_\_ T\_\_ R\_\_  
S\_\_ T\_\_ R\_\_  
S\_\_ T\_\_ R\_\_

Property in Sec.

S\_\_ T\_\_ R\_\_

Register of Deeds Stamp & File Number

4. Lot No. \_\_\_\_\_, Recorded Plat \_\_\_\_\_  
5. Private Claims \_\_\_\_\_

Sep 24 2002

I, Stephan J. Szyszkoski, in a field survey on 19 do hereby state that under requirements of P.A. 74, Michigan P.A. of 1970, the corner points mentioned in lines 1 and 2 above were in conformance with regulations and rules therefore as required in the current manual of survey instructions of the United States Department of the Interior, Bureau of Land Management or by a decree of a Court of Law and for that the corner points mentioned in lines 3, 4 and 5 above were in conformance with the rules of the Michigan Board of Land Surveyors or by a Decree of a Court of Law, established, re-established, monumented, recovered, found as expressed below:

NOTE: Not more than 2 corners, all in the same town and range, may be recorded on this certificate.

A. Description of original monument and accessories and/or subsequent restoration:  
(2-Sec. 16) East 1/16 corner between 9 and 16. Not established in the original survey.


1	A	B	C	D	E	F	G	H	I	J	K	L	M
2	6	5			4			3		2		1	
3													
4	7		8		9			10		11		12	
5													
6	10		17		16			15		14		13	
7													
8	19		20		21			22		23		24	
9													
10	30		29		28			27		26		25	
11													
12	31		32		33			34		35		36	
13													

B. Description of corner evidence found and/or method applied in restoring or reestablishing corner:

(2-Sec. 16) Found a 1/2" dia. rebar with plastic cap # 22428 at the proper position and accepted same.

C. Description of monument for corner and accessories established to perpetuate locating the position of the corner:

(2) Found 1/2" dia. rebar with plastic cap # 22428, flush, blazed, scribed, and set measuring nails in:  
10" W. Pine N08W 19.6' "E1/16 8T"  
12" W. Pine N86E 15.45' do  
8" Spruce S31W 15.05' do  
4" clump Maple N77W 18.45' do  
Set cedar post adjacent. Bearings are magnetic. Distances to nail with tag.

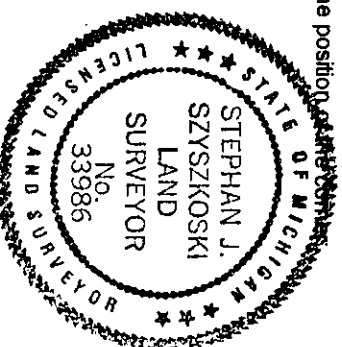

Signed by Stephan J. Szyszkoski  
Surveyor's Michigan License No. 33986

Date 12/3/02

For the Michigan Department of Natural Resources - Office of Property Management  
FORM Approved by MICHIGAN STATE BOARD OF PROFESSIONAL SURVEYORS, JAN. 28, 1971

REVISED MAY 14, 1975  
REVISED JAN., 1983  
REVISED OCT., 1985