

LAND CORNER RECORDATION CERTIFICATE
Filing Requirement of Act 74, Mich. P.A. 1970

SURVEY &
REMONUMENTATION

FEB 27 1997

COMMISSION

Register of Deeds Stamp & File Number

For corners in

MACOMB
(County)

Located in: Clinton
Township

Corner Code #

Public Land Survey

T 2N R 13E A-12

T R

T R

T R

Property Controlling
in Section

S T R

S T R

Miscellaneous

S T R

Property in Sec.

S T R

Lot No. , Recorded Plat

Private Claims

Randy Kolehouse, in a field survey on April 23 19 96,

do hereby certify that under requirements of P.A. 74 Michigan P.A. of 1970, the corner points mentioned in lines 1 and 2 above were in conformance with regulations and rules therefore as required in the current manual of survey instructions of the United States Department of the Interior, Bureau of Land Management or by a decree of a Court of Law and/or that the corner points mentioned in lines 3, 4 and 5 above were in conformance with the rules of the Michigan Board of Land Surveyors or by a Decree of a Court of Law; established, re-established, monumented, re-monumented, recovered, found as expressed below:

NOTE: Not more than 4 corners, all in the same town and range, may be recorded on this certificate.

Description of original monument and accessories and/or subsequent restoration:

-12 Records indicate this corner is common to M-12, T2N, R12E.

1817	G.L.O. Notes	Preston	N/A	Set Post in Swamp
N/A	MCRC	N/A	N/A	Iron 4" Down
1981	L.C.R.C. L. 3383 P. 589	Smith	#16052	1/2" Iron
1991	L.C.R.C. L. 5286 P. 196	Smith	#16052	1/2" Pipe
1991	L.C.R.C. L. 05292 P. 723	Patterson	#17631	1/2" Iron Pipe
1992	L.C.R.C. L. 5304 P. 557	Newman	#24607	1/2" Pipe

Description of corner evidence found and/or method applied in restoring or reestablishing corner:

-12 I found a 1/2" pipe in a monument box at the C/L of Hayes Road (asph.) running North and South which checks with the following witnesses. No witnesses were given in Preston's G.L.O. notes and no witnesses remain from L.C.R.C. L. 3383 P. 589 and the undated Macomb County Road Commission records.

L.C.R.C. L. 05286 P. 196
33.53 FT. N. 45° W, P.K. Nail in S. Face of D.E. Pole (m. 33.61')
60.03 West, Nail & D.E. Cap in S. Face of 10" Maple Tree (m. 60.08')
81.50 Ft. N. 45° E. to Nail & Cap, N.W. Face of 36" Maple Tree (m. 81.05')

L.C.R.C. L. 5304 P. 557
N 50° W 33.58' P.P. (m. 33.61')
N 50° E 81.13' 30" Oak (m. 81.05')
West 61.55' 12" Maple (m. 61.60')

L.C.R.C. L. 05292 P. 723
P.K. Nail in 30" Elm N 50° E. 81.12 ft. (m. 81.05')
P.K. Nail in 8" Maple N. 85° W. 61.55 ft. (m. 61.60')
Nail in U.P. N. 50° W. 33.57 ft. (m. 33.61')

ACCEPTED BY THE MACOMB COUNTY SURVEY PEER
GROUP AS THE OFFICIAL CORNER UNDER MICHIGAN
PUBLIC ACT 345 OF 1990 AT A MEETING HELD
ON 10-23-1996

WILLIAM E. SODERBERG, P.S., CHAIRMAN

Measure North 2666.07' to A-11 (G.L.O. = 2640.0') (Fraser Meadows North Sub. No. 1 L. 102 P. 32 = 2666.04')
Measure South 2669.45' to A-13 (G.L.O. = 2640.0') (Fieldstone Sub. L. 96 P. 43 = 2669.43')

Description of monument for corner and accessories established to perpetuate locating the position of the corner:

-12 I replaced the found 1/2" pipe with a 3/4" x 24" iron rod w/2" diameter aluminum cap stamped "Macomb County Monument MI Act 345 #25854" in an existing monument box.


N 63° E 81.05' - Found P.K. Nail in NW Face 36" Oak
S 36° E 48.17' - Found "+" N Rim Gate Well
N 87° W 60.08' - Found P.K. Nail w/MCR Tag in S Face 12" Maple
N 57° W 33.61' - Found P.K. Nail in S Face P. Pole

The selected location is accepted by me and is generally accepted by professional surveyors as the best available evidence of the position of the original corner.

Signed by Randy J. Kolehouse

Date 11/19/96

Surveyor's Michigan License No. 25854

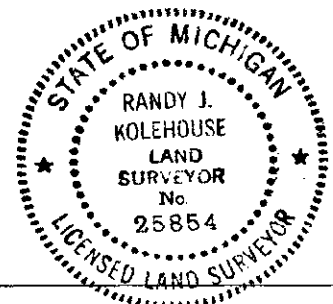

FORM APPROVED BY MICHIGAN STATE BOARD OF LAND SURVEYORS, JAN. 28, 1971
REVISED MAY 14, 1975
REVISED JAN., 1983