

SURVEY &
REMONUMENTATION

APR 28 1995

C152221

COMMISSION

LAND CORNER RECORDATION CERTIFICATE 94 DEC 14 AM 10:52
Filing Requirement of Act 74, Mich. P.A. 1970

For corners in

MACOMB

(County)

Located In: Clinton
Township

Corner Code ##

MAUGH
DEEDS
CTY, MI

LIBER 6527 PAGE 798

Register of Deeds Stamp & File Number

1. Public Land Survey T R Other #1
T R
T R
T R
2. Property Controlling S 19 T 2N R 13E Property Controlling
in Section S T R Corner on Section Line
3. Miscellaneous S T R Common to 19 & 20.
Property in Sec. S T R N Side Huron River.
North of C-8.

4. Lot No. , Recorded Plat
5. Private Claims

I, Randy Kolehouse, in a field survey on Sept. 28, 19 94,
do hereby certify that under requirements of P.A. 74, Michigan P.A. of 1970, the corner points mentioned
in lines 1 and 2 above were in conformance with regulations and rules therefore as required in the
current manual of survey instructions of the United States Department of the Interior, Bureau of Land
Management or by a decree of a Court of Law and/or that the corner points mentioned in lines 3, 4 and 5
above were in conformance with the rules of the Michigan Board of Land Surveyors or by a Decree of a
Court of Law; established, re-established, monumented, re-monumented, recovered, found as
expressed below:

**NOTE: Not more than 4 corners, all in the same town and range, may be recorded
on this certificate.**

A. Description of original monument and accessories and/or subsequent restoration:

1817 G.L.O. Notes Preston NA Post

No other evidence of corner.

B. Description of corner evidence found and/or method applied in restoring or reestablishing corner:


G.L.O. set meander post on north bank of Huron River at 30.94 Ch. (2042.0') South of section corner common to
17, 18, 19 & 20. Searched for corner but found no evidence. Found PK on line extended south from Section
corner common to Sections 17, 18, 19 & 20 using C/L of Garfield Road right-of-way per Macomb County Road
Commission Road Improvement Plans at the intersection of Clinton River Road. Said point is 1679.56' South of
Section corner and 17.00 feet west of a line between Section corners. Held point for a property controlling corner
north side Clinton River. This point is in the center line \pm of Clinton River Road.

ACCEPTED BY THE MACOMB COUNTY SURVEY PEER
GROUP AS THE OFFICIAL CORNER UNDER MICHIGAN
PUBLIC ACT 345 OF 1990 AT A MEETING HELD
ON 10-4-94
William E. Soderberg
WILLIAM E. SODERBERG, P.S., CHAIRMAN

C. Description of monument for corner and accessories established to perpetuate locating the position of the corner:

Set a 3/4" x 24" Iron rod w/2" diameter aluminum cap stamped "Macomb County
Monument MI Act 345 #25854," also set Monument Box.

PK & Macomb Co. Remon. Tag in NW Face Util. Pole S 65° W 78.98'
PK & Macomb Co. Remon. Tag in W Face Util. Pole S 23° E 37.19'
PK & Macomb Co. Remon. Tag in NE Face Util. Pole S 44° E 118.41'
PK & Macomb Co. Remon. Tag in SE Face Util. Pole N 78° E 133.23'
SW Bolt to Sign Base N 77° E 130.85'
C/L Top Nut on Hyd. N 25° W 72.63'

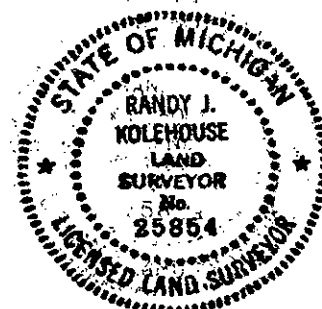

Signed by Randy J. Kolehouse

Date 10/14/94

Surveyor's Michigan License No. 25854