

SURVEY & REMONUMENTATION

APR 28 1995 C0158312 LIBER:06543 PAGE:334 08:35A 01/05/1995
CARMELLA SABAUGH-MACOMB COUNTY, MI REG/DEEDS

COMMISSION

LAND CORNER RECORDATION CERTIFICATE
Filing Requirement of Act 74, Mich. P.A. 1970

For corners in

Macomb (County) Located In: Shelby Twp. Corner Code H-11

1. Public Land Survey	T	3N.	R	12E.	H-11
	T		R		
	T		R		
	T		R		
2. Property Controlling in Section	S		T	R	
	S		T	R	
3. Miscellaneous Property in Sec.	S		T	R	
	S		T	R	

Register of Deeds Stamp & File Number

4. Lot No. , Recorded Plat
5. Private Claims

I, Warren C. Avey, in a field survey on September 16, 1994, do hereby certify that under requirements of P.A. 74, Michigan P.A. of 1970, the corner points mentioned in lines 1 and 2 above were in conformance with regulations and rules therefore as required in the current manual of survey instructions of the United States Department of the Interior, Bureau of Land Management or by a decree of a Court of Law and/or that the corner points mentioned in lines 3, 4 and 5 above were in conformance with the rules of the Michigan Board of Land Surveyors or by a Decree of a Court of Law; established, re-established, monumented, re-monumented, recovered, found as expressed below:

NOTE: Not more than 4 corners, all in the same town and range, may be recorded on this certificate.

A. Description of original monument and accessories and/or subsequent restoration:

Date	What	L.	P.	Who	Surveyor's ID	Corner Type	Mon. Box
1817	GLO			Wampler	N/A	Post	No

B. Description of corner evidence found and/or method applied in restoring or reestablishing corner:

Found PK nail in Asph. 0.02's & 0.08'E. of a point mid-way and on line between G-11 and I-11.
Set Corner mid-way and on line between G-11 and I-11.
N-S location supported by corners in: S/P Wallace Sub. L.18, P.41
Roy Fischer Sub. L.35, P.23

H-11 - I-11 = 2654.40'
H-11 - G-11 = 2654.40'


C. Description of monument for corner and accessories established to perpetuate locating the position of the corner:

Set 3/4" Bar w/Alum Cap stamped "Macomb County Monument - MI. ACT 345" 30076 in new Monument Box in Asphalt

AZ 132° 44.95' to PK nail in LLS Disk #30092 N.E. face Util. Pole
AZ 203° 34.35' to PK nail in MCW tag S.E. face Util. Pole
AZ 305° 72.43' to centerline stem on Fire Hydrant
AZ 33° 61.50' to PK nail in MCW tag S.E. face Util. Pole

The selected location is a careful and faithful re-establishment of the position of the original corner.

Signed by Warren C. Avey
Surveyor's Michigan License No. 30076

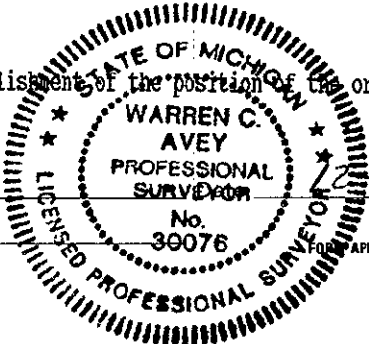

	A	B	C	D	E	F	G	H	I	J	K	L	M
2	6		5		4		3		2		1		
3													
4	7		8		9		10		11		12		
5													
6	18		17		16		15		14		13		
7													
8	19		20		21		22		23		24		
9													
10	30		29		28		27		26		25		
11													
12	31		32		33		34		35		36		
13													

ACCEPTED BY THE MACOMB COUNTY SURVEY PEER GROUP AS THE OFFICIAL CORNER UNDER MICHIGAN PUBLIC ACT 345 OF 1990 AT A MEETING HELD ON 9-27-94
William E. Soderberg, P.S., CHAIRMAN