

LIBER 061668001

B999614

LAND CORNER RECORDATION CERTIFICATE

Filing Requirement of Act 74, Mich. P.A. 1970.

For corners in

Macomb

(County)

Located In:
Chesterfield

Corner Code #

RECORDED IN MACOMB COUNTY

RECORDS AT: 8:30 A.M.

DEC 28 1993

Leimilla Arbaugh
CLERK - REGISTER OF DEEDS
MACOMB COUNTY, MICHIGAN

Register of Deeds Stamp & File Number

1. Public Land Survey T 3 N R 14 E M 3
T R
T R
T R
2. Property Controlling S T R
in Section S T R
3. Miscellaneous S T R
Property in Sec. S T R
4. Lot No. , Recorded Plat
5. Private Claims

I, Steven E. Dunn, in a field survey on December 8, 19 93, do hereby certify that under requirements of P.A. 74, Michigan P.A. of 1970, the corner points mentioned in lines 1 and 2 above were in conformance with regulations and rules therefore as required in the current manual of survey instructions of the United States Department of the Interior, Bureau of Land Management or by a decree of a Court of Law and/or that the corner points mentioned in lines 3, 4 and 5 above were in conformance with the rules of the Michigan Board of Land Surveyors or by a Decree of a Court of Law; established, re-established, monumented, re-monumented, recovered, found as expressed below:

NOTE: Not more than 4 corners, all in the same town and range, may be recorded on this certificate.

A. Description of original monument and accessories and/or subsequent restoration:

GLO Post - No evidence of original corner found.

GLO Original survey performed by Preston 2-18-1818.

Certificate of Survey:

(M.C.R.) L.2882, P.473	Herbert J. Kobs	#14097	November 22, 1977
(S.C.C.R.) L.10, P.29	Michael J. Rossow	#24615	November 24, 1987
(S.C.C.R.) L.13, P.236 & 237	Robert Smith	#16052	October 21, 1992
(M.C.R.) L.5878, P.343	Gerald G. James	#19835	June 4, 1993
L.C.R.C.: L.2882, P.490	Herbert J. Kobs	#14097	November 22, 1977
L.4353, P.426	Herbert G. Avey	#15396	January 12, 1988


B. Description of corner evidence found and/or method applied in restoring or reestablishing corner:

M-3 Found 1" Axle Shaft in Monument Box as described in above Certificate of Survey (L.2882, P.473) and L.C.R.C.'s found Witnesses match those stated in above documents.

Placed Macomb County Monument Marker #28408 on 1" Axle Shaft in Monument Box.

ACCEPTED BY THE MACOMB COUNTY
SURVEY PEER GROUP AS THE OFFICIAL
CORNER UNDER MICHIGAN PUBLIC ACT 345
OF 1990 AT A MEETING HELD ON
12-20-93

Frank J. Decker
FRANK J. DECKER, PS, PE, CHAIRMAN

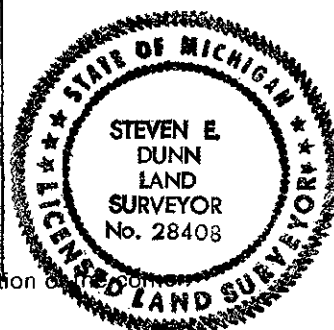

C. Description of monument for corner and accessories established to perpetuate locating the position of corner:

M-3, T.3n., R.14E.

Macomb County Monument Marker #28408 on 1" Axle Shaft in Monument Box.

Witnesses:

N.50°E. - 43.75' Found Nail and Tag in South face of Utility Pole.
S.23°E. - 67.22' Found P.K. Nail in NE face of Utility Pole.
N.30°W. - 37.85' Scribed "+" on East end of North concrete headwall.
S.71°W. - 37.85' Scribed "+" on East end of South concrete headwall.

The selected location is a careful and faithful perpetuation of the position of the original corner.

Signed by Steven E. Dunn

Date 12-20-93

Surveyor's Michigan License No. 28408