

LIBER 06166PG017

R999630

## LAND CORNER RECORDATION CERTIFICATE

Filing Requirement of Act 74, Mich. P.A. 1970

For corners in

Macomb

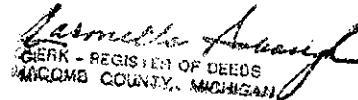
(County)

Located In:  
Washington Twp.

Corner Code ##

RECORDED IN MACOMB COUNTY  
RECORDS AT: 8:30 A M.

DEC 28 1993

  
 CLERK - REGISTER OF DEEDS  
 MACOMB COUNTY, MICHIGAN

Register of Deeds Stamp &amp; File Number

1. Public Land Survey

T 4 R 12

D-13

T R

T R

T R

2. Property Controlling  
in Section

S T R

S T R

3. Miscellaneous  
Property in Sec.

S T R

S T R

4. Lot No. \_\_\_\_\_, Recorded Plat \_\_\_\_\_

5. Private Claims \_\_\_\_\_

	A	B	C	D	E	F	G	H	I	J	K	L	M
2	6	5	4	3	2	1							
3													
4	7	8	9	10	11	12							
5													
6	18	17	16	15	14	13							
7													
8	19	20	21	22	23	24							
9													
10	30	29	28	27	26	25							
11													
12	31	32	33	34	35	36							
13													

I, Huston K. Kennedy, in a field survey on December 10, 1993, do hereby certify that under requirements of P.A. 74, Michigan P.A. of 1970, the corner points mentioned in lines 1 and 2 above were in conformance with regulations and rules therefore as required in the current manual of survey instructions of the United States Department of the Interior, Bureau of Land Management or by a decree of a Court of Law and/or that the corner points mentioned in lines 3, 4 and 5 above were in conformance with the rules of the Michigan Board of Land Surveyors or by a Decree of a Court of Law; established, re-established, monumented, re-monumented, recovered, found as expressed below:

**NOTE: Not more than 4 corners, all in the same town and range, may be recorded on this certificate.**


A. Description of original monument and accessories and/or subsequent restoration:

1817-GLO Wampler, D.S.; Set post; 15" Black Oak N55°W 11 Lns; 24" Black Oak S57°E 83 Lns  
 1986 Kobs, P.S. #14097; Survey L.3880, Pg.94 - Fnd 3/4" Iron Rod  
 1986 Kobs, P.S. #14097; Survey L.3880, Pg.96 - Same wits as 1986 Survey  
 1986 Kobs, P.S. #14097; LCRC L.3880, Pg.118- Same wits as 1986 Survey

B. Description of corner evidence found and/or method applied in restoring or reestablishing corner:

1993 Kennedy Surveying, Inc. - Kennedy, P.S. #17623 - Fnd 1/2" Iron Rod w/cap #30085 that is located 68'± North of the North edge of Westbound 26 Mile Road, which is concrete surface. There is a sparse tree line extending to the North.

Two witness points from the 1986 LCRC were found and they were used to recover and verify the found 1/2" Iron Rod w/cap #30085.

ACCEPTED BY THE MACOMB COUNTY  
 SURVEY PEER GROUP AS THE OFFICIAL  
 CORNER UNDER MICHIGAN PUBLIC ACT 345  
 OF 1990 AT A MEETING HELD ON  
12-15-93  
  
**FRANK J. DODECKER, PS, PE, CHAIRMAN**

C. Description of monument for corner and accessories established to perpetuate location of the corner:

D-13 I replaced the found 1/2" Iron Rod w/cap #30085 with a 3/4" x 24" Iron Rod w/2" diameter aluminum cap stamped "Macomb County Monument MI Act 345 #17623" in a monument box.  
 S42°W-97.94'-Chiseled cross in station 70+00 WB 26 Mile Road  
 Due West-44.73'-Set PK Nail & Remon. tag in North face Power Pole  
 N72°W-53.39'-Set PK Nail & Remon. tag above existing witness in 33" Oak  
 Due North-83.32'-Set PK Nail & Remon. tag in West face 27" Oak (w/15" Oak)

The selected location is accepted by me and is generally accepted by Professional Surveyors as the best available of the position of the original corner.

Signed by H K KennedyDate 12-10-93Surveyor's Michigan License No. 17623

FORM APPROVED BY MICHIGAN STATE BOARD OF LAND SURVEYORS, JAN. 28, 1971  
 REVISED MAY 14, 1975  
 REVISED JAN., 1983