

LAND CORNER RECORDATION CERTIFICATE  
Filing Requirement of Act 74, Mich. P.A. 1970

For corners in

Macomb Located In: Ray Twp Corner Code #  
(County)  
1. Public Land Survey T 4N R 13E C-13  
T R  
T R  
T R  
2. Property Controlling S T R  
in Section S T R  
3. Miscellaneous S T R  
Property in Sec. S T R

SURVEY &  
RECORD DOCUMENTATION

APR 20 2000

SECTION

Register of Deeds Stamp & File Number

4. Lot No. , Recorded Plat  
5. Private Claims


I, Robert D. Kohn, in a field survey on November 30, 1996 do hereby state that under requirements of P.A. 74, Michigan P.A. of 1970, the corner points mentioned in lines 1 and 2 above were in conformance with regulations and rules therefore as required in the current manual of survey instructions of the United States Department of the Interior, Bureau of Land Management or by a decree of a Court of Law and /or that the corner points mentioned in lines 3, 4 and 5 above were in conformance with the rules of the Michigan Board of Land Surveyors or by a Decree of a Court of Law; established, re-established, monumented, recovered, found as expressed below:

NOTE: Not more than 2 corners, all in the same town and range, may be recorded on this certificate.

C0458205 LIBER:07298 PAGE:238 10:47A 01/02/1997  
CARMELLA SABAUGH-MACOMB COUNTY, MI REG/DEEDS

A. Description of original monument and accessories and/or subsequent restoration:

	1817	Post	W. Preston	N/A	G.L.O. Notes
1980	1/2" iron bar in mon box	H. Kobs	#14097	L.C.R.C. L3287 P577	
1984	1/2" iron bar in mon box	H. Kobs	#14097	Survey L3795 P109	
1992	N/A	G. James	#19835	Survey L5625 P260	
1995	1/2" bar in mon box	J. Wright	#40165	Unrecorded Survey sketch Urban Land Consultants Job #940826-3994	

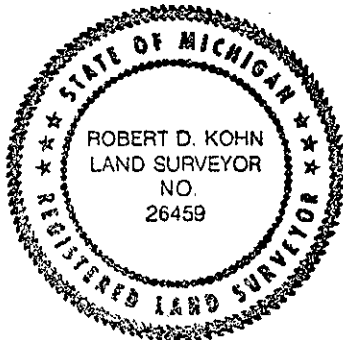

B. Description of corner evidence found and/or method applied in restoring or reestablishing corner:

A 1/2" iron rod in an existing monument box in asphalt pavement currently occupies this corner. The following witness ties were used to recover and verify its position:

2 ties match witnesses from L.C.R.C. L3287 P577  
2 ties match witnesses from Survey L3795 P109

Field measurements were observed between the following corners:

B-13 to C-13	2687.05' meas.	C-1 to C-13	61.29' meas.	C-13 to D-1	2606.90 meas.
	2640.00' rec. G.L.O.		61.38' rec. G.L.O.		2606.68' rec. Survey L3795 P109
			61.33' rec. survey L5625 P260		
			61.28' rec. survey L3795 P109		

C. Description of monument for corner and accessories established to perpetuate locating the position of the corner:

I replaced the existing 1/2" iron rod with a 3/4" x 24" iron rod with a 2" diameter aluminum cap stamped "Macomb County Monument Act 345 #26459" in an existing monument box in asphalt pavement. The witness ties are as follows:

N22°E.	40.78'	P.K. nail and Mac Co remon washer in S.E. face U-pole
Due West	61.29'	Mac Co remon cap #26459 in mon box (C-1) Mac. Twp.
S21°W.	35.63'	Found nail & tag #26003 in S.W. face U-pole
S45°E.	51.75'	Center top nut fire hydrant

ACCEPTED BY THE MACOMB COUNTY SURVEY PEER GROUP AS THE OFFICIAL CORNER UNDER MICHIGAN PUBLIC ACT 345 OF 1990 AT A MEETING HELD ON 7-23-96

William E. Soderberg  
WILLIAM E. SODERBERG, P.S., CHAIRMAN

The selected location is accepted by me and generally accepted by Professional Surveyors as the best available evidence of the position of the original corner.

Signed by Robert D. Kohn  
Surveyor's Michigan License No. #26459

Date November 30, 1996