

MAR 17 2000

LAND CORNER RECORDATION CERTIFICATE  
Filing Requirement of Act 74, Mich. P.A. 1970

For corners in


Macomb  
(County)

Located In: Ray Twp. Corner Code #

SECTION


1091834  
LIBER 9268 PAGE 22  
12/27/1999 01:15:42 P.M.  
MACOMB COUNTY, MI  
CARMELLA SABAUGH, REG/DEEDS

1. Public Land Survey T-4-N R-13-E E-11  
T R  
T R  
T R  
2. Property Controlling S T R  
in Section S T R  
3. Miscellaneous S T R  
Property in Sec. S T R

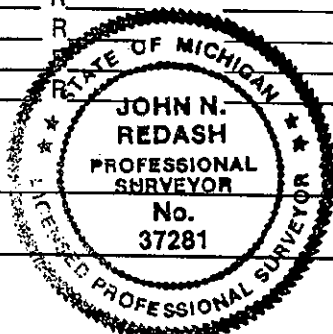

Register of Deeds Stamp & File Number

4. Lot No. , Recorded Plat  
5. Private Claims

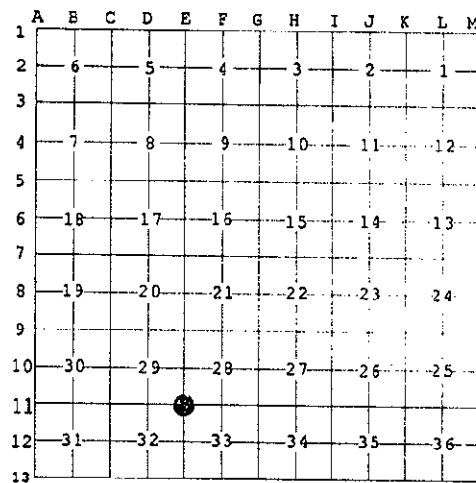

I, John N. Redash, in a field survey on Jan. 13, 1999 do hereby state that under requirements of P.A. 74, Michigan P.A. of 1970, the corner points mentioned in lines 1 and 2 above were in conformance with regulations and rules therefore as required in the current manual of survey instructions of the United States Department of the Interior, Bureau of Land Management or by a decree of a Court of Law and /or that the corner points mentioned in lines 3, 4 and 5 above were in conformance with the rules of the Michigan Board of Land Surveyors or by a Decree of a Court of Law; established, re-established, monumented, recovered, found as expressed below:

NOTE: Not more than 2 corners, all in the same town and range, may be recorded on this certificate.

A. Description of original monument and accessories and/or subsequent restoration:

|      |                  |             |            |        |                                       |
|------|------------------|-------------|------------|--------|---------------------------------------|
| 1817 | Set Post         | G.L.O Notes | W. Preston | N/A    |                                       |
| 1977 | iron in mon. box | LCRC        | W. Coulter | #14760 | L 2828, P 442                         |
| 1978 | Railroad spike   | LCRC        | H. Kobs    | #14097 | L 2964, P 811                         |
| 1978 | Railroad spike   | Survey      | H. Kobs    | #14097 | P 794 & L 3062, P 536 & L 2964, P 794 |
| 1979 | Railroad spike   | LCRC        | H. Kobs    | #14097 | L 3062, P 513                         |
| 1987 | Railroad spike   | LCRC        | D. King    | #30085 | L 4306, P 698                         |
| 1987 | Railroad spike   | Survey      | D. King    | #30085 | L 4306, P 707                         |
| 1993 | Railroad spike   | Survey      | D. King    | #30085 | L 5969, P 136 & L 6555, P 49          |
| 1998 | Railroad spike   | Survey      | D. King    | #30085 | L 8045, P 016                         |
| 1995 | Railroad spike   | LCRC        | D. King    | #30085 | L 6586, P 208                         |

B. Description of corner evidence found and/or method applied in restoring or reestablishing corner:

A 1/2" iron rod with cap #30085 in asphalt pavement of 27 Mile Road currently occupies this corner. ON KUNSTMAN ROAD NORTH (GRAVEL)  
The following witnesses were used to recover and verify its position:  
Two ties matched current measurements from LCRC's L 2828, P 442; L 2964, P 811; L 3062, P 513;  
L 4306, P 698; L 6586, P 208.

Field measurements were observed between the following corners:

|                                    |               |                                   |               |                                  |               |
|------------------------------------|---------------|-----------------------------------|---------------|----------------------------------|---------------|
| D-11 to E-11                       | 2689.35 meas. | E-11 to F-11                      | 2679.14 meas. | E-11 to E-12                     | 2663.65 meas. |
| 2651.22 Rec. G.L.O. (40.17 Chains) |               | 2640.00 Rec. G.L.O. (40 Chains)   |               | 2640.00 G.L.O. (40 Chains)       |               |
| 2689.28 Rec. Survey L 3126, P 157  |               | 2679.18 Rec. Survey L 5969, P 136 |               | 2663.58 Rec. Survey L 8045, P 16 |               |
| L 3062, P 536                      |               |                                   |               | L 5969, P 136                    |               |
| 2689.47 Rec. Survey L 8045, P 16   |               |                                   |               |                                  |               |

C. Description of monument for corner and accessories established to perpetuate locating the position of the corner:

I replaced the 1/2" iron rod w/cap #30085 with a 3/4" x 24" iron rod with a 2" diam. aluminum cap stamped "Macomb County Monument MI ACT 345 #37281" in a new monument box.

Witnesses are as follows:

|         |             |  |
|---------|-------------|--|
| Az 24°  | 79.42 feet  | Set mag nail and Macomb County Remon Tag in northeast face of utility pole |
| Az 128° | 42.81 feet  | Set mag nail and Macomb County Remon Tag in southwest face of utility pole |
| Az 262° | 195.92 feet | Set mag nail and Macomb County Remon Tag in north face of utility pole     |
| Az 281° | 198.30 feet | Set mag nail and Macomb County Remon Tag in south face of utility pole     |

The selected location is accepted by me and generally accepted by Professional Surveyors as the best available evidence of the position of the original corner.

Signed by John N. Redash  
Surveyor's Michigan License No. 37281

Date 11/22/99

962