

1993

LAND CORNER RECORDATION CERTIFICATE
Filing Requirement of Act 74, Mich. P.A. 1970

COMMISSION

For corners in

Manistee
(County)

Located In:

Corner Code ##

- | | | | | | |
|------------------------------------|---|-----|---|-----|-----|
| 1. Public Land Survey | T | 21N | R | 13W | I-4 |
| | T | | R | | |
| | T | | R | | |
| | T | | R | | |
| 2. Property Controlling in Section | S | T | R | | |
| | S | T | R | | |
| 3. Miscellaneous Property in Sec. | S | T | R | | |
| | S | T | R | | |

REGISTER'S OFFICE
MANISTEE COUNTY

#93-283 AT 9:50 A.M.

MAY 12 1993

Pammy C. Pedersen
REGISTER OF DEEDS

Register of Deeds Stamp & File Number

4. Lot No. _____, Recorded Plat _____
5. Private Claims _____

I, Norman C. Caldwell, in a field survey on September, 1992, do hereby certify that under requirements of P.A. 74, Michigan P.A. of 1970, the corner points mentioned in lines 1 and 2 above were in conformance with regulations and rules therefore as required in the current manual of survey instructions of the United States Department of the Interior, Bureau of Land Management or by a decree of a Court of Law and/or that the corner points mentioned in lines 3, 4 and 5 above were in conformance with the rules of the Michigan Board of Land Surveyors or by a Decree of a Court of Law; established, re-established, monumented, re-monumented, recovered, found as expressed below:

NOTE: Not more than 4 corners, all in the same town and range, may be recorded on this certificate.

A. Description of original monument and accessories and/or subsequent restoration:

- I-4 Post placed by J. Brink, 1838
8" W. Pine S28°W 17 lks. (11.22')
8" J. Pine N35°E 18 lks. (11.88')

B. Description of corner evidence found and/or method applied in restoring or reestablishing corner:

- I-4 1/4 cor., Sec. 10 & 11, T21N-R13W

1909 Survey by B.L. Caukin (Fargo Eng. Co)
for Consumers Power Co.
Fnd. No U.S. evidence
Set Stake
N74°W 1.5chs (99') 8" Norway
S86°E 1.89chs (124.74') 30" W. Pine stump
S40°E 0.96 1/4ch (63.52') 10" Norway

County Surveyor's Record by E.W. M.
in July 1914
N83°W 79.20' 6" B. Oak
N74°W 72.93' 8" Norway
S40°E 63.53' 10" Norway
N72 3/4°E 39.60' 10" B. Oak
S86°E 124.74' 30" W. Pine stump


Survey by Anthony M. Slawinski in 1972
Recorded in L.1, P. 61, & L.72, P.11
Fnd. Cabin spike
SE 86.98' 8" Oak
SW 75.17' 5" Oak

Survey by Sammy S. Barnett in Aug. 1979
(not recorded)
Fnd. Large spike
No Wits. given

C. Description of monument for corner and accessories established to perpetuate locating the position of the corner:

- I-4 1/4 cor., Sec. 10 & 11, T21N-R13W

Fnd. dock spike over 1/2" rebar per L.1, P.61 & L.72, P.11
replaced with 5" x 5" x 36" conc. post w/brass tablet
and is accepted as a careful and faithful reestablishment
of the position of the original corner.
S25°E 86.92' 12" Black Oak (R)
S46°W 75.42' 10" White Oak (R)
N34°W 81.30' 12" B. Oak
N81°W 89.53' N. Tower Leg
East 33.00' Carsonite Witness Post

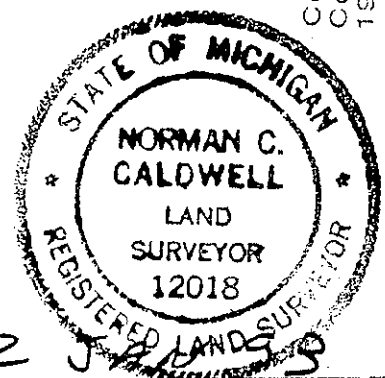

Signed by *Norman C. Caldwell*
Surveyor's Michigan License No. 12018

Date

12 5 1993