

"Other Code 4"

LAND CORNER RECORDATION CERTIFICATE
Filing Requirement of Act 74, Mich. P.A. 1970

For corners in

Manistee
(County)

Located In:

Corner Code #

E-6i F-6i
E-5.5, E-F-5/6

1. Public Land Survey

T 21N R 13W

T R

T R

T R

2. Property Controlling
in Section

S T R

S T R

3. Miscellaneous
Property in Sec.

S T R

S T R

4. Lot No. , Recorded Plat

5. Private Claims

REGISTER'S OFFICE
MANISTEE COUNTY

93-339 AT 3 16 p.m.

MAY 12 1993

Penny A. Perna
REGISTER OF DEEDS

Register of Deeds Stamp & File Number

INDIAN
RESERVE

	A	B	C	D	E	F	G	H	I	J	K	L	M
2	6	5	4	3	2	1							
3													
4	7	8	9	10	11	12							
5													
6	18	17	16	15	14	13							
7													
8	19	20	21	22	23	24							
9													
10	30	29	28	27	26	25							
11													
12	31	32	33	34	35	36							
13													

I, Norman C. Caldwell, in a field survey on September, 1992, do hereby certify that under requirements of P.A. 74, Michigan P.A. of 1970, the corner points mentioned in lines 1 and 2 above were in conformance with regulations and rules therefore as required in the current manual of survey instructions of the United States Department of the Interior, Bureau of Land Management or by a decree of a Court of Law and/or that the corner points mentioned in lines 3, 4 and 5 above were in conformance with the rules of the Michigan Board of Land Surveyors or by a Decree of a Court of Law; established, re-established, monumented, re-monumented, recovered, found as expressed below:

NOTE: Not more than 4 corners, all in the same town and range, may be recorded on this certificate.

A. Description of original monument and accessories and/or subsequent restoration:

E-5.5 I.R. Boundary bet. Sec. 16 & 17, post established by John Brink, August 1, 1837.
S50°W 35 lks. (23.10') 8" Hemlock
S85°E 54 lks. (35.64') 11" Hemlock

E-F-5/6


S.E. Corner of I.R., post established by John Brink, May 1837.
S57°E 35 lks. (23.10') 12" Y. Pine
N44°W 65 lks. (42.90') 14" Y. Pine

B. Description of corner evidence found and/or method applied in restoring or reestablishing corner:

E-5.5 Cor. common to Gov't Lots 1 & 8, Sec. 17, T21N-R13W
No Subsequent Record

E-F-5/6

SE cor. Indian Res. boundary Sec. 16, T21N-R13W
No Subsequent Record

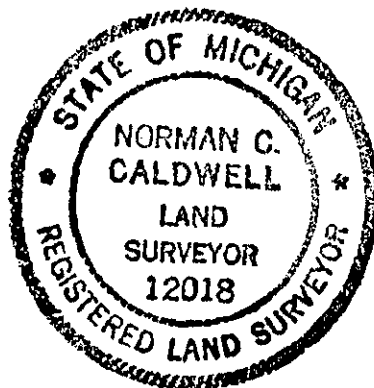

C. Description of monument for corner and accessories established to perpetuate locating the position of the corner:

E-5.5 Cor. common to Gov't Lots 1 & 8, Sec. 17, T21N-R13W
Placed 2" diam. iron pipe w/brass cap 35'± W. of W. bank Pine River and is accepted as a careful and faithful reestablishment of the position of the original corner.
N12°W 37.70' 6" W. Pine
S58°E 36.45' 6" W. Oak
S12°E 38.72' 6" W. Oak
N69°W 43.52' S.E. Cor. Building
North 1.0' Carsonite Witness Post
South 198.42' 1/4 cor., Sec. 16 & 17, T21N-R13W
(IN RIVER)

E-F-5/6

SE cor. Indian Res. boundary Sec. 16, T21N-R13W
Placed 2" diam. iron pipe w/brass cap 35'± W. of W. bank Pine River and is accepted as a careful and faithful reestablishment of the position of the corner.
S27°E 14.61' 4" W. Pine
S60°W 14.67' 14" W. Oak
N09°E 39.43' 12" W. Oak
N80°E 47.95' 10" W. Oak
North 1.0' Carsonite Witness Post

Signed by

Date

12 JAN 93

Surveyor's Michigan License No.

12018